


Beltway Business Community


3600 Commerce Drive
Suites 611-612
Baltimore, MD 21227

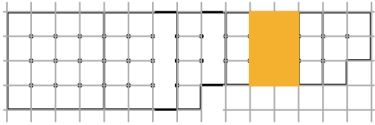

Building Key Plan

Total SF Available
5,400 SF

Office - 1,576 SF
Warehouse - 3,824 SF

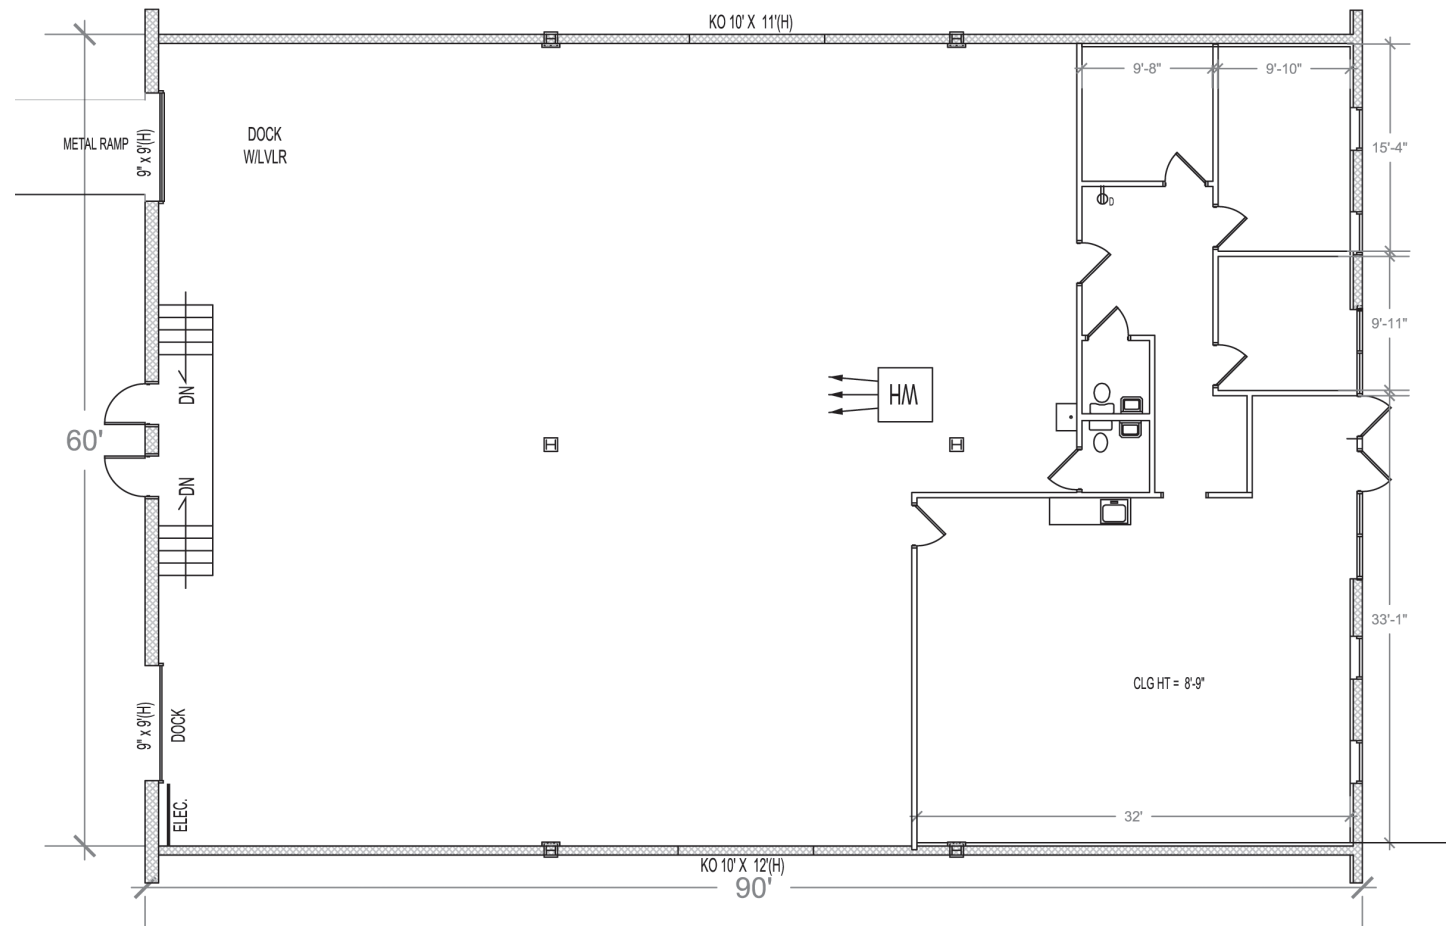

Plan not to scale - this is not a construction document.