


Hammonds South


611 Hammonds Ferry Road
Suites L-N
Linthicum, MD 21090

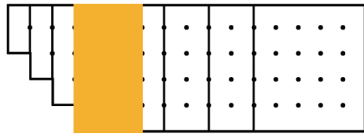

Building Key Plan

Total SF Available - 15,300 SF

Office - 4,305 SF
Warehouse - 10,995 SF

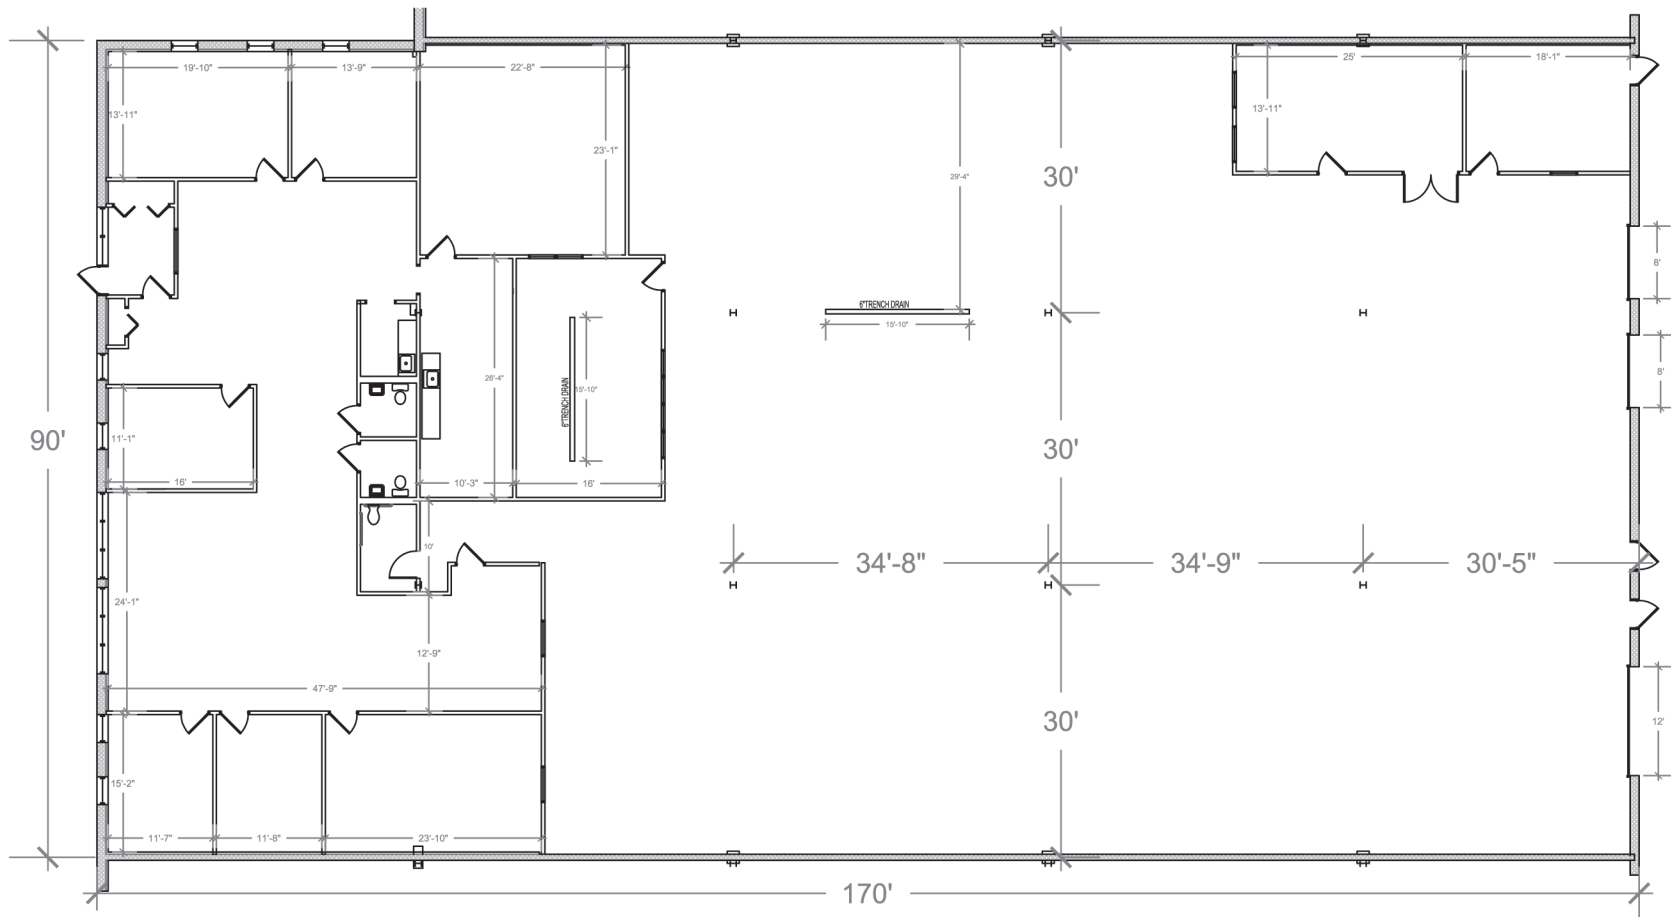

Plan not to scale - this is not a construction document.