


Baltimore Commons


7455 New Ridge Road, Suite A-B
Hanover, MD 21076

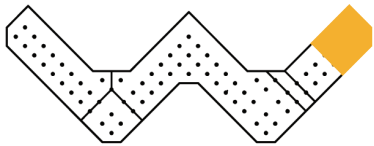

Building Key Plan

Total SF Available
11,550 SF

Office - 3,791 SF
Warehouse - 7,759 SF

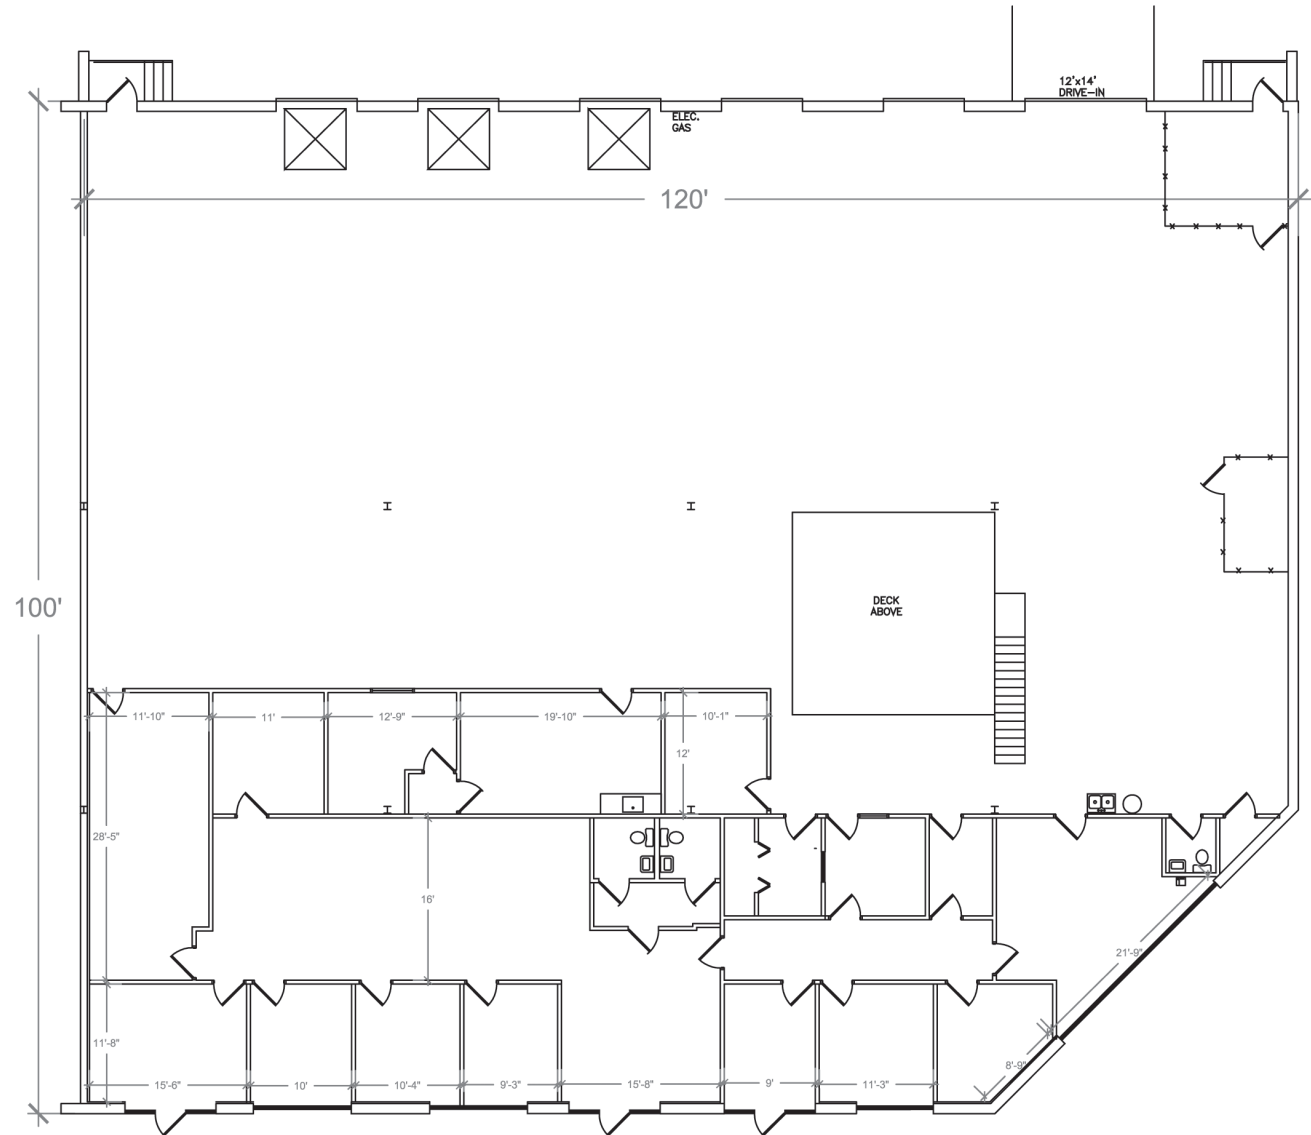

Plan not to scale - this is not a construction document.