



# Curtis Business Center

717 East Ordnance Road  
Suites 203-204  
Baltimore, MD 21226

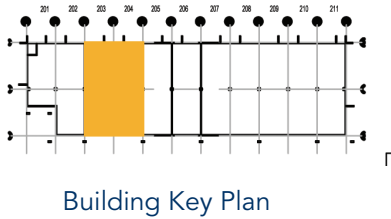

Total SF Available  
4,000 SF

Office - 1,325 SF  
Warehouse - 2,675 SF

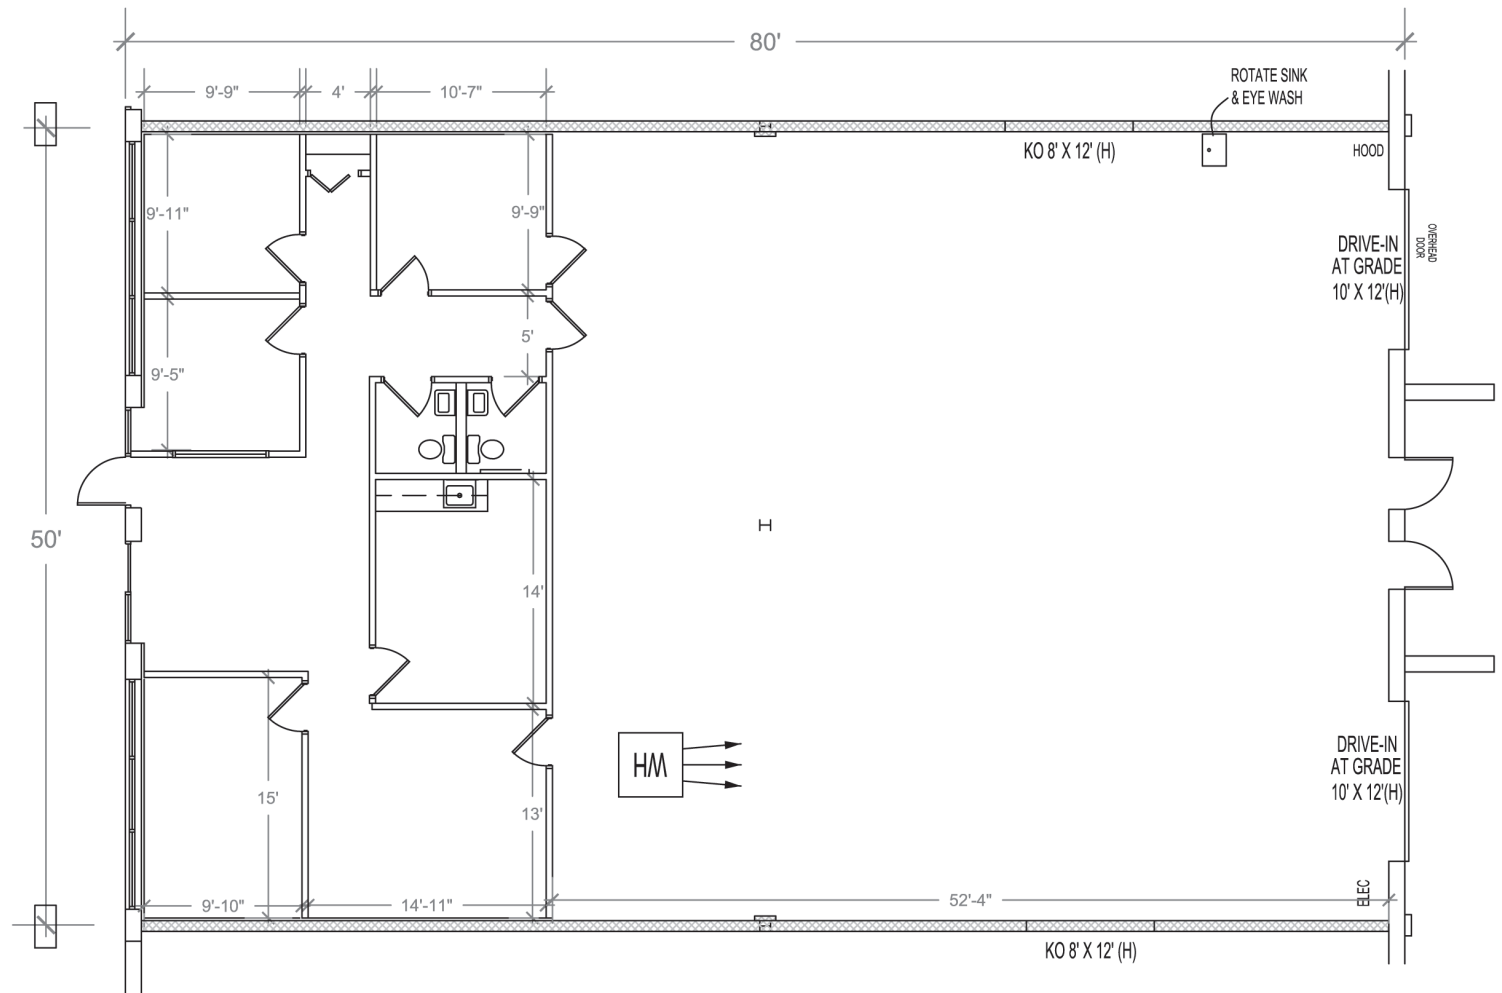

Plan not to scale - this is not a construction document.