


Curtis Business Center

703 East Ordnance Road
Suites 605-607
Baltimore, MD 21226



Building Key Plan

Total SF Warehouse Available
8,100 SF

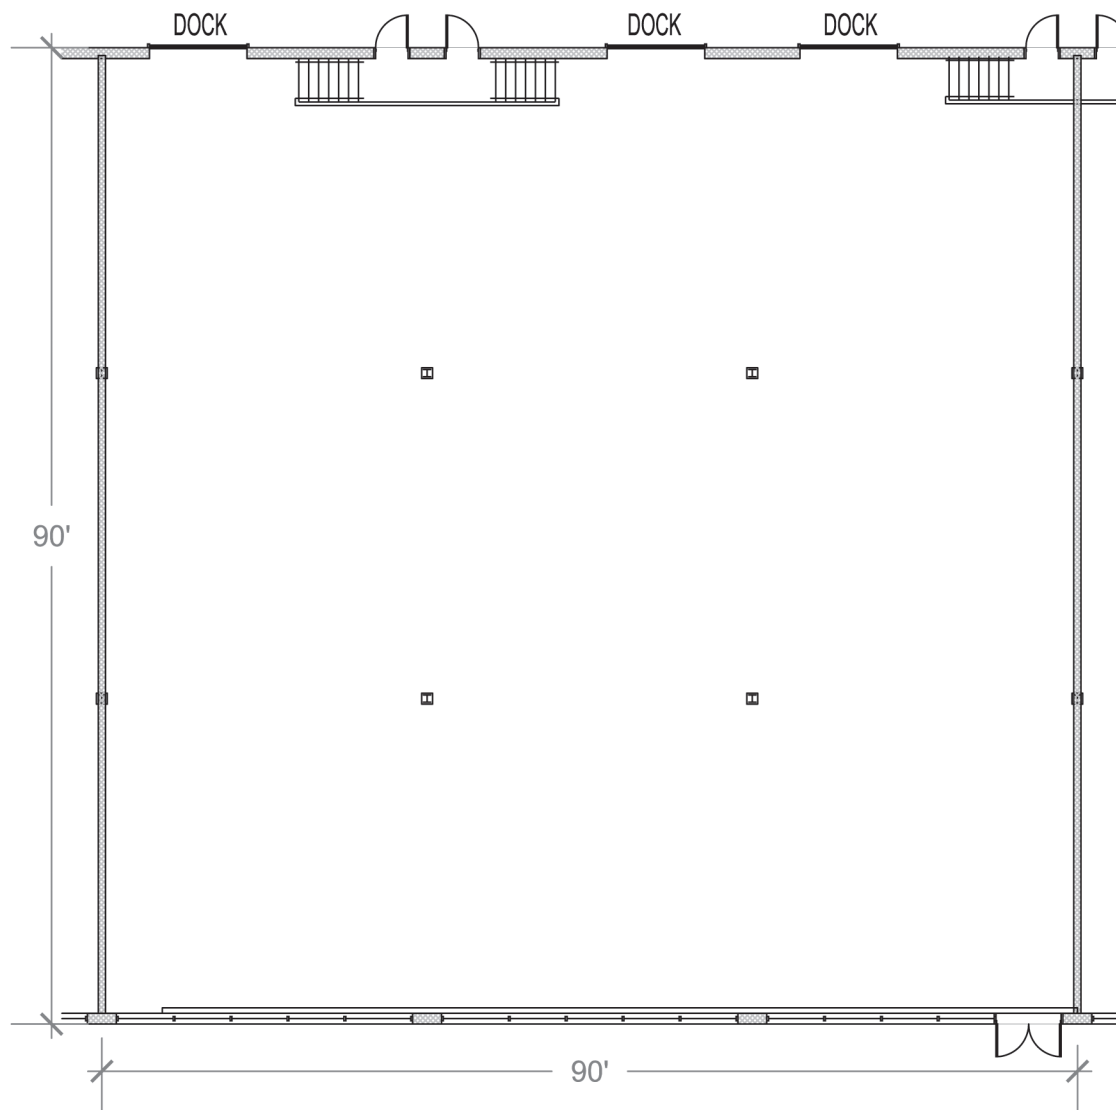

Plan not to scale - this is not a construction document.