


Curtis Business Center


703 East Ordnance Road
Suite 610
Baltimore, MD 21226

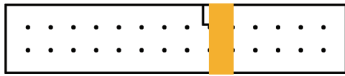

Building Key Plan

Total SF Available - 2,627 SF

Office - 1,255 SF
Warehouse - 1,372 SF

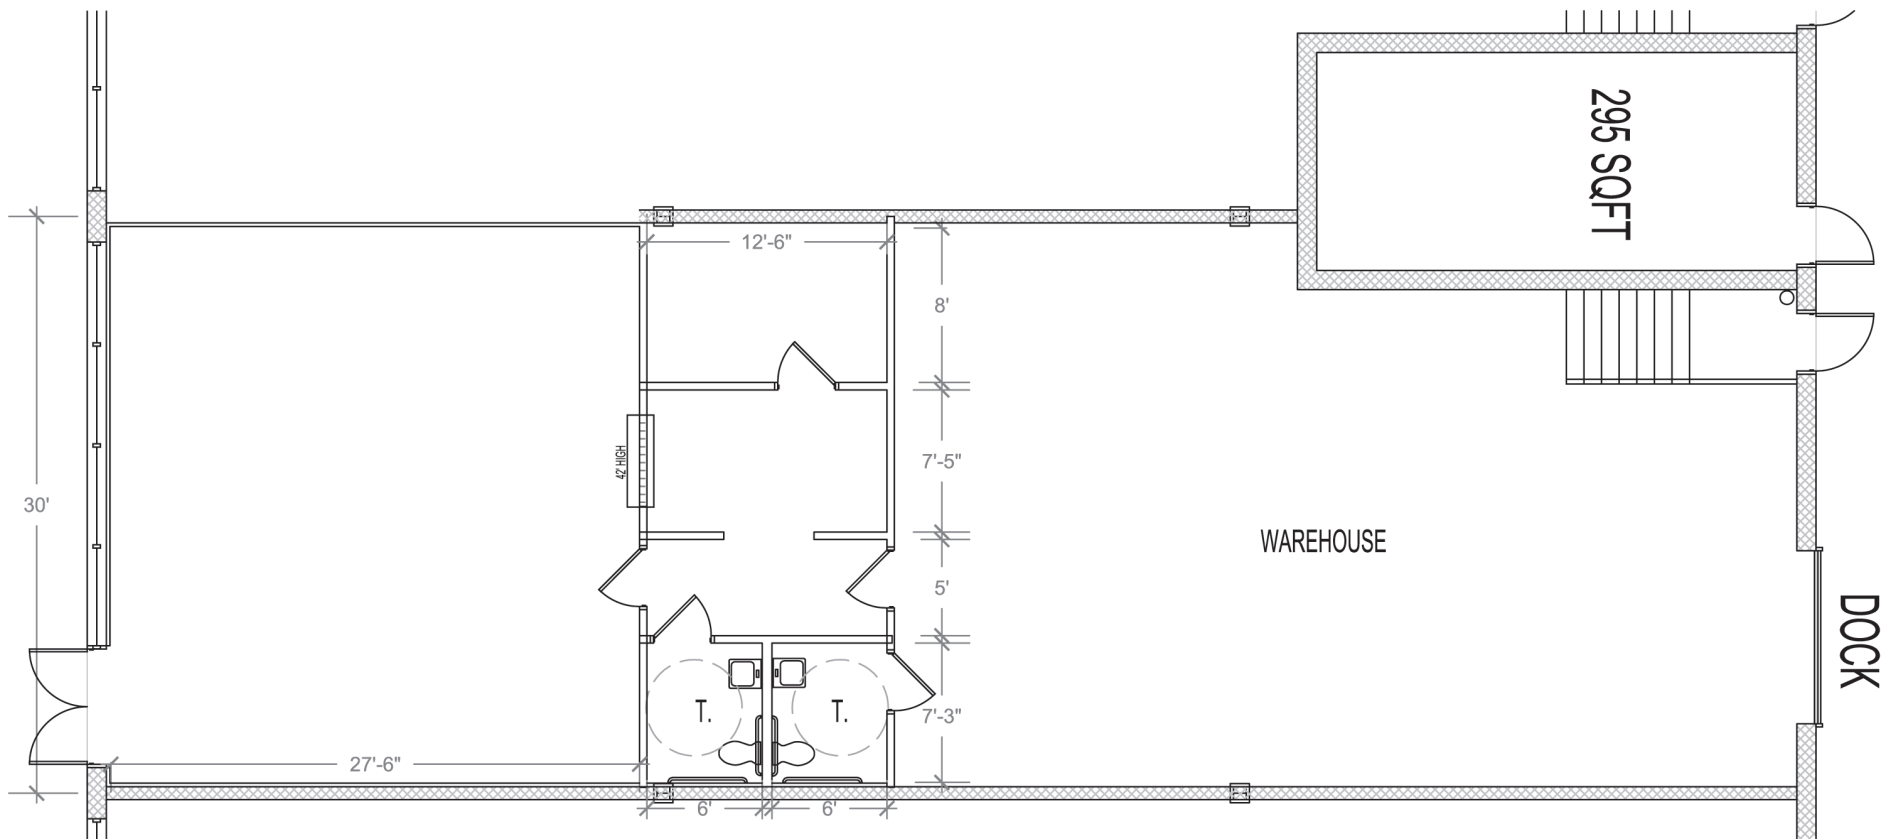

Plan not to scale - this is not a construction document.