




# Blades Lane 150 Blades Lane, Suite A-B Glen Burnie, MD 21061

Office Flex Warehouse Distribution Design-Build Green-Build Retail

Nearly 15 million square feet throughout the Baltimore/Washington area

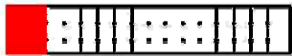


BUILDING KEY PLAN

AVAILABLE - 5,950 SF

- 1,980 SF - OFFICE
- 3,970 SF - WAREHOUSE
- 5,950 SF - TOTAL

*Plan not to scale - this is not a construction document*

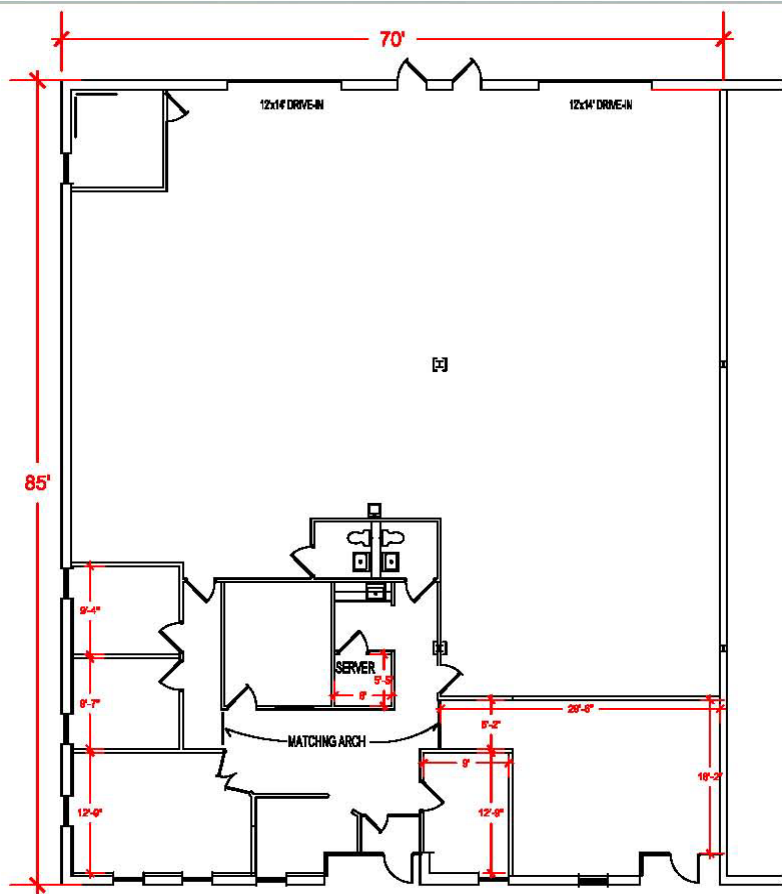

BLADES LANE ▪ 150 BLADES LANE, SUITE A-B ▪ GLEN BURNIE ▪ MD 21061