



Oregon Avenue

821 Oregon Avenue
Suites A-B
Linthicum, MD 21090

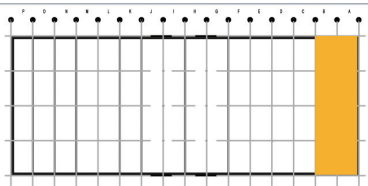

Building Key Plan

Total SF Warehouse Available
12,500 SF

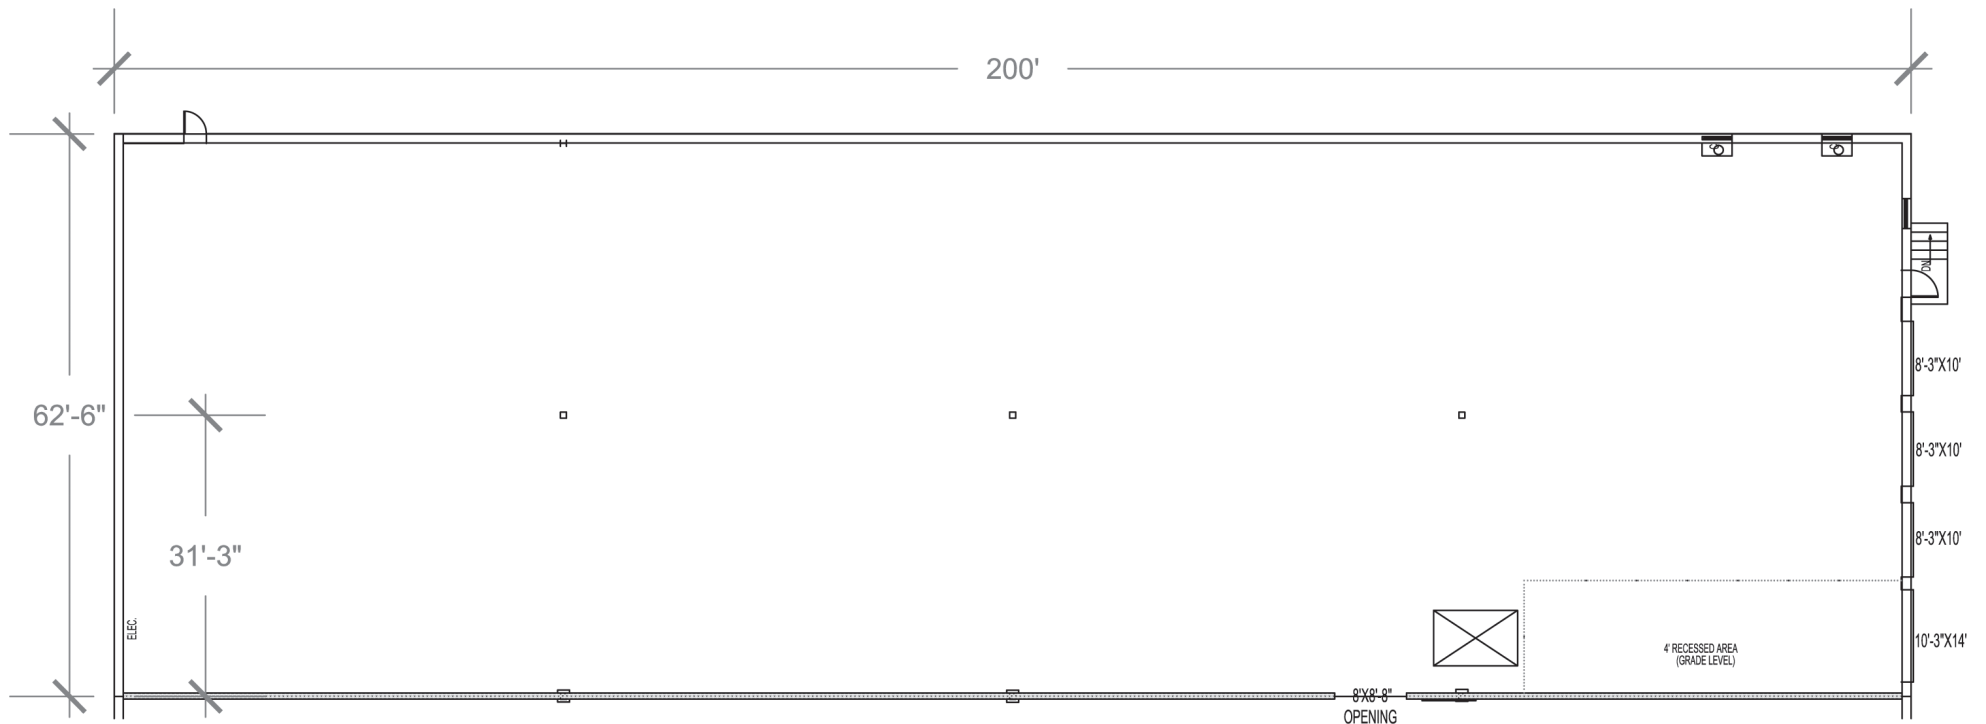

Plan not to scale - this is not a construction document.