



Oregon Avenue

821 Oregon Avenue, Suite E-F
Linthicum, MD 21090

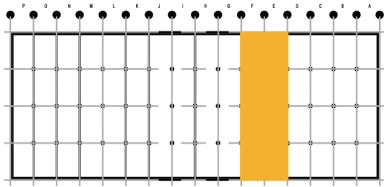

Building Key Plan

Total Warehouse Space Available
12,500 SF

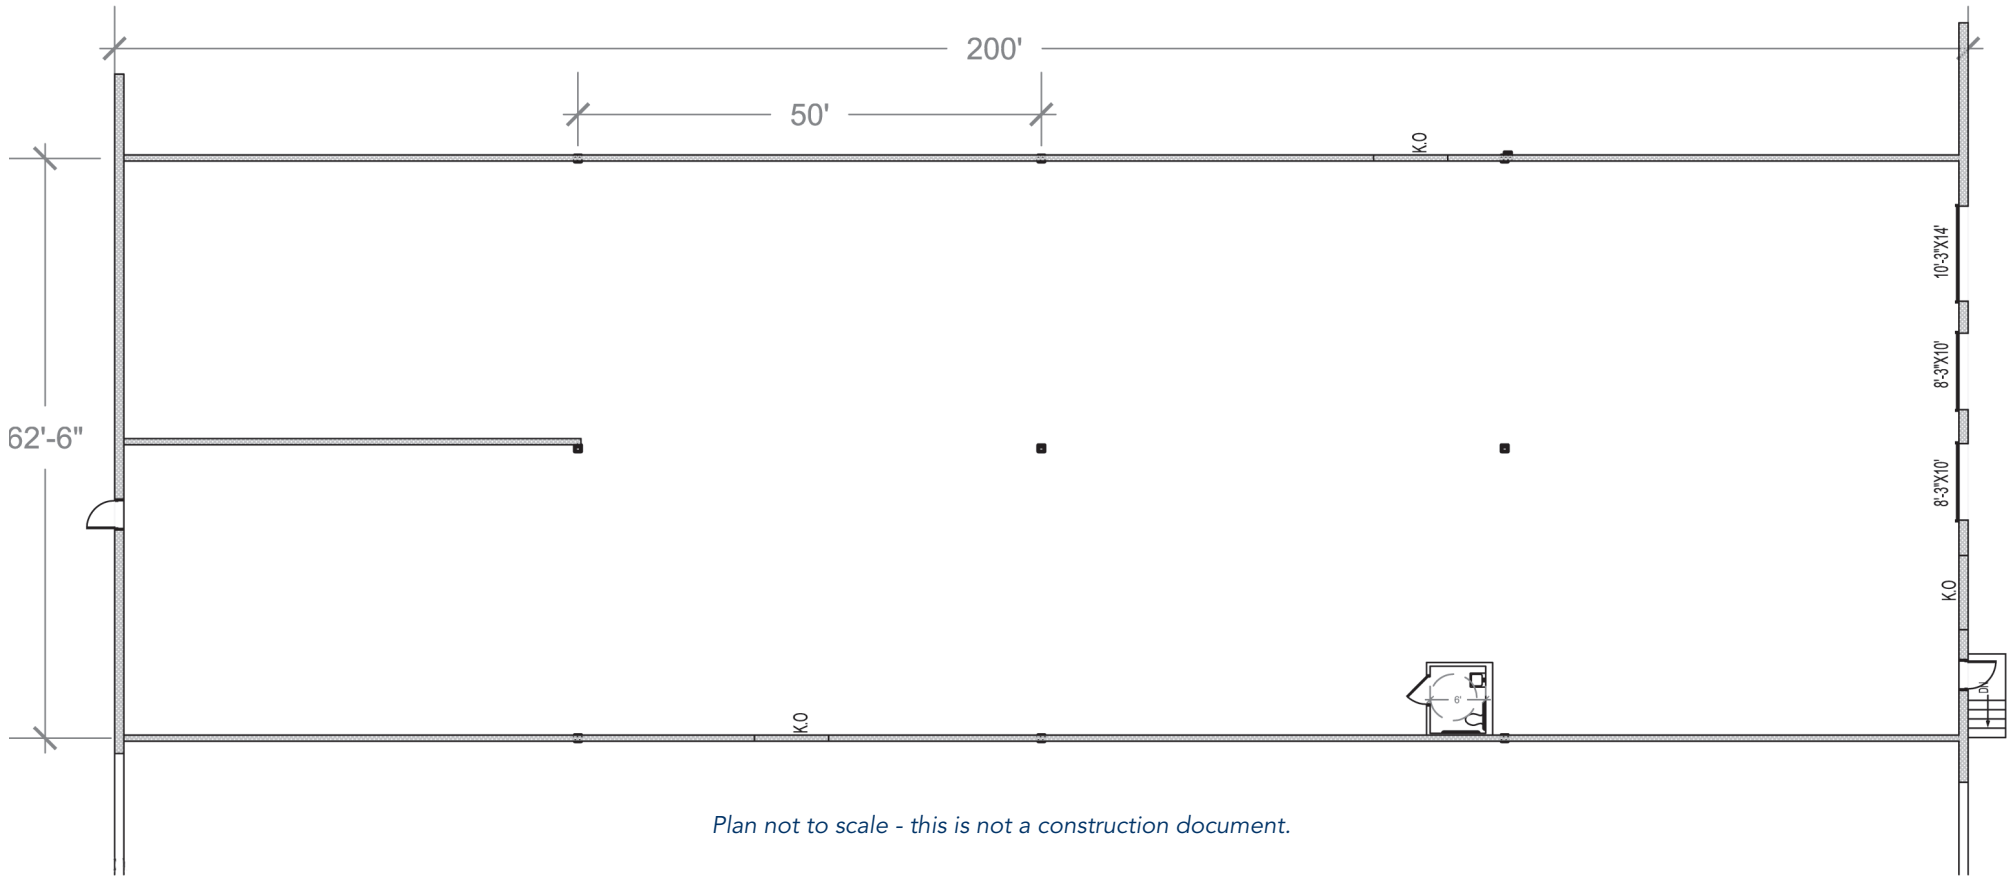

Plan not to scale - this is not a construction document.