



# Oregon Avenue

821 Oregon Avenue  
Suites G-H  
Linthicum, MD 21090

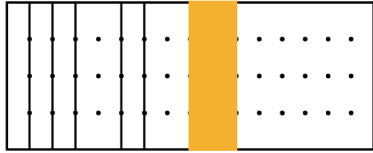

Building Key Plan

Total SF Warehouse Available  
**12,500 SF**

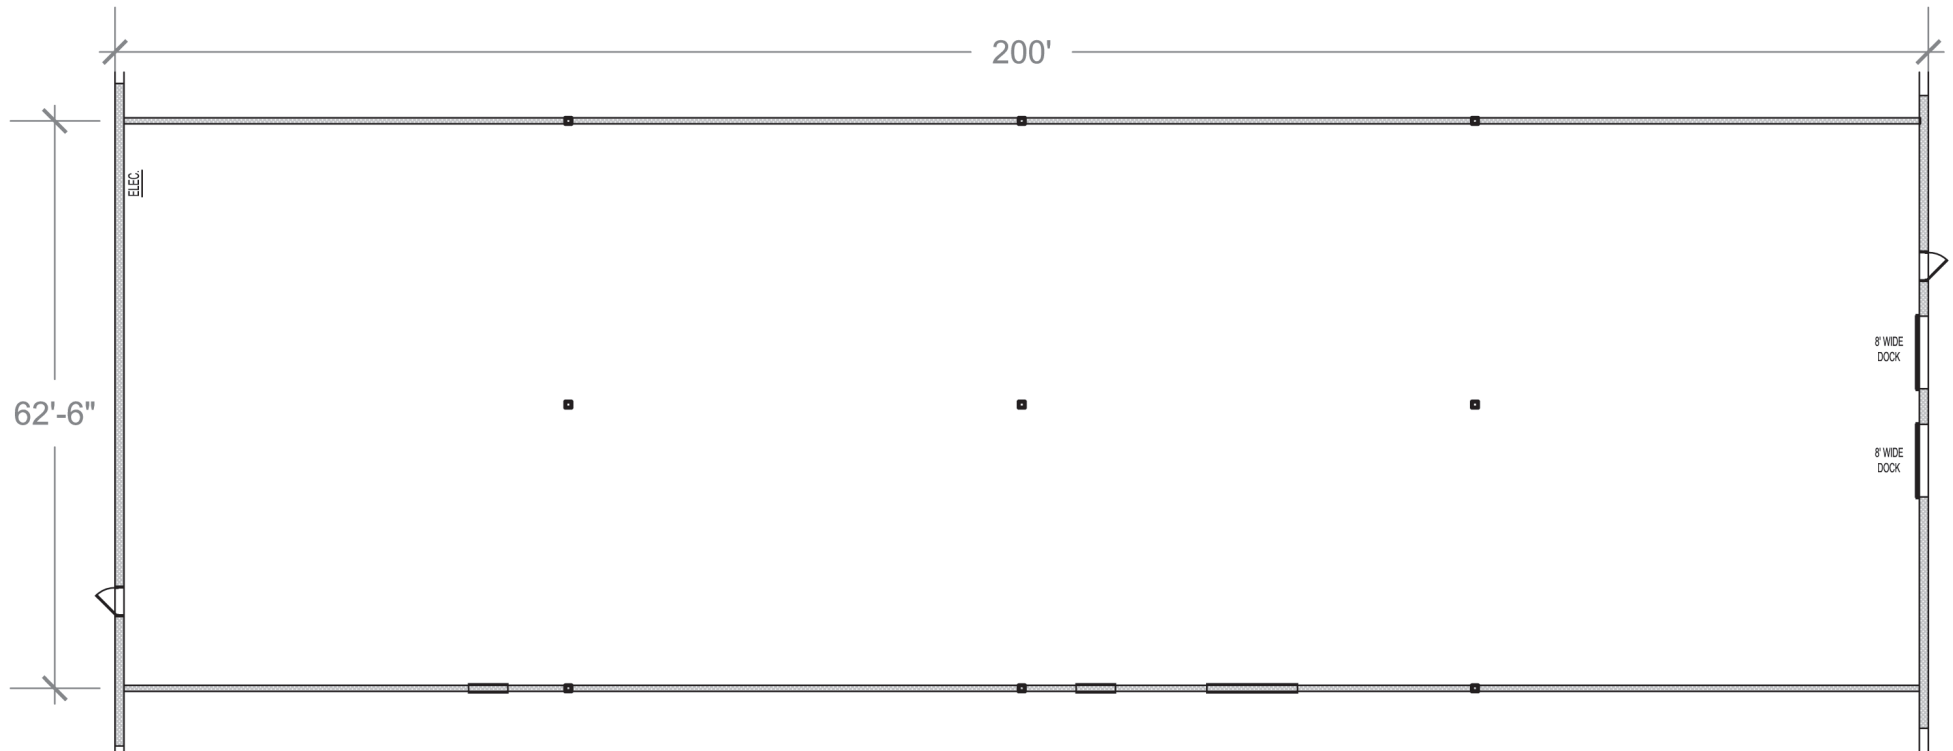

*Plan not to scale - this is not a construction document.*