



Oregon Avenue

821 Oregon Avenue, Suite P
Linthicum, MD 21090

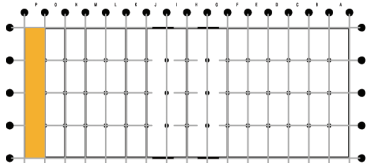

Building Key Plan

Total SF Warehouse Available
6,250 SF

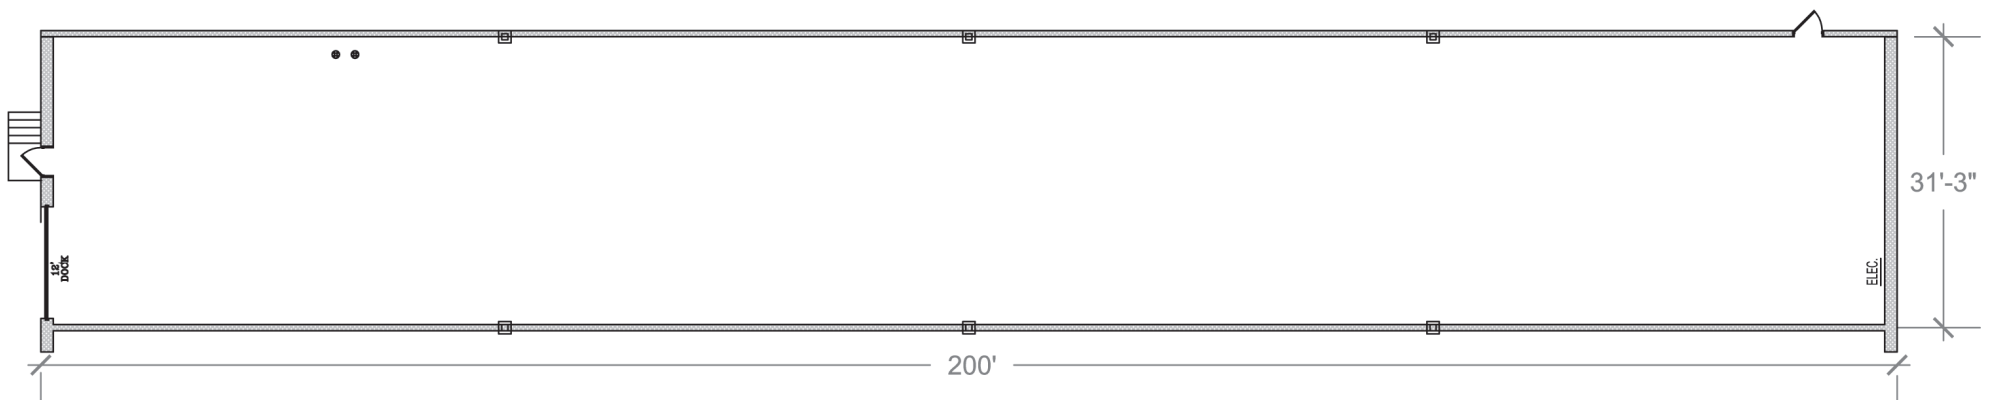

Plan not to scale - this is not a construction document.