


# Oregon Avenue


832 Oregon Avenue  
Suite G  
Linthicum, MD 21090

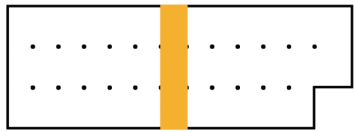

Building Key Plan

Total SF Available - 3,072 SF

Office - 806 SF  
Warehouse - 2,266 SF

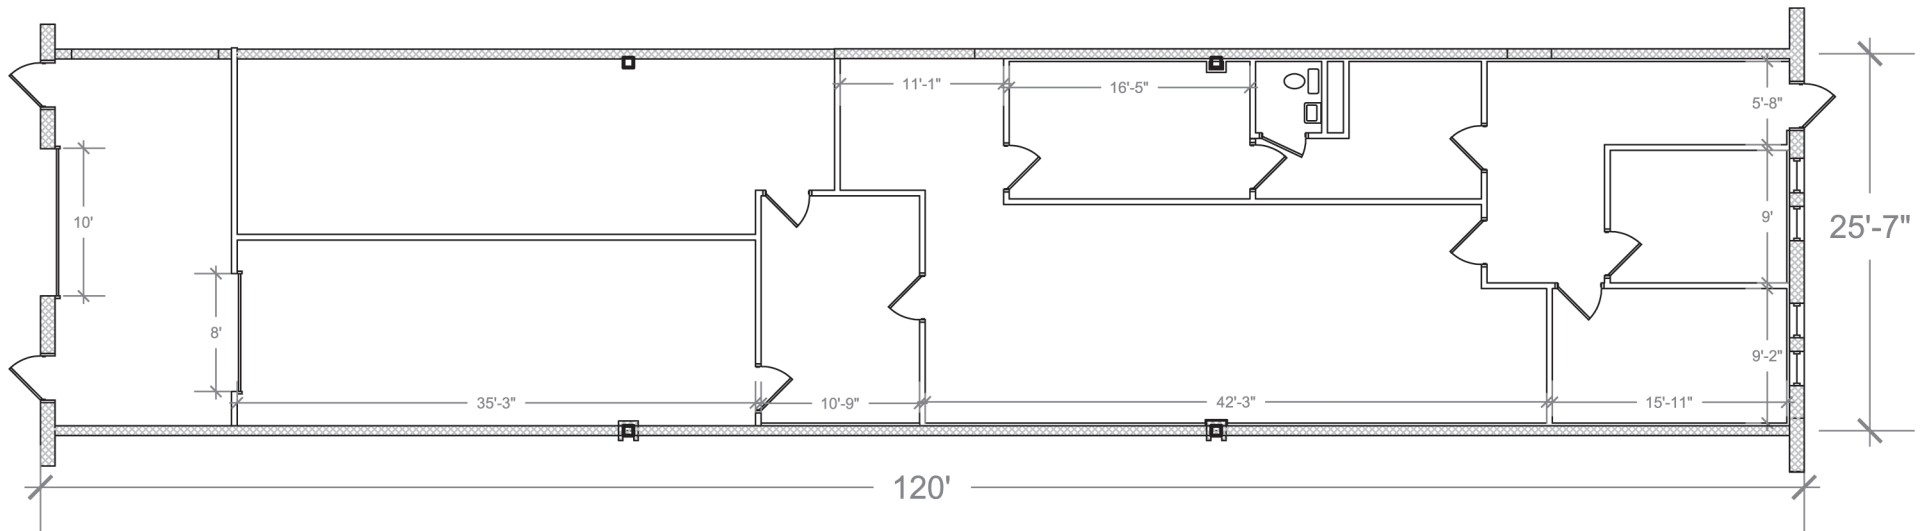

*Plan not to scale - this is not a construction document.*