


Oregon Avenue


832 Oregon Avenue
Suites K-L
Linthicum, MD 21090

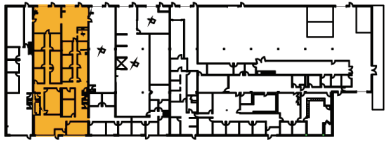

Building Key Plan

Total SF Available - 6,000 SF

Office - 4,938 SF
Warehouse - 1,062 SF

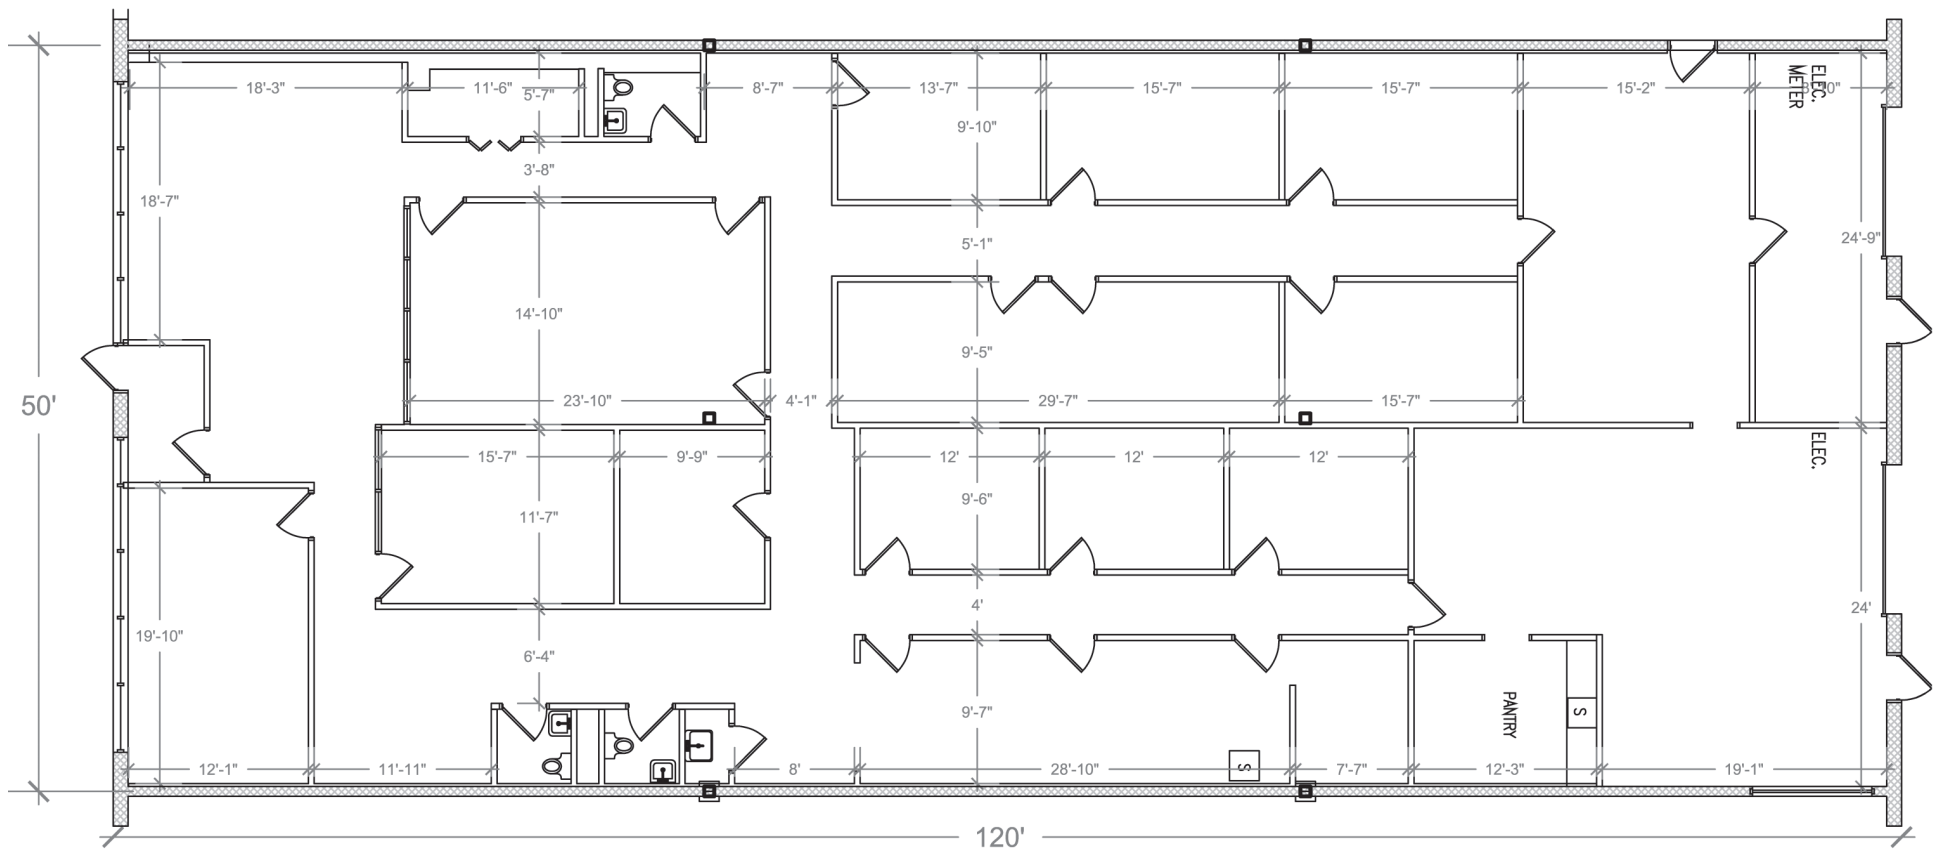

Plan not to scale - this is not a construction document.