



Oregon Avenue

821 Oregon Avenue
Suite K
Linthicum, MD 21090

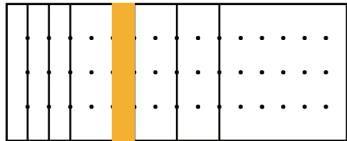

Building Key Plan

Total SF Warehouse Available
6,250 SF

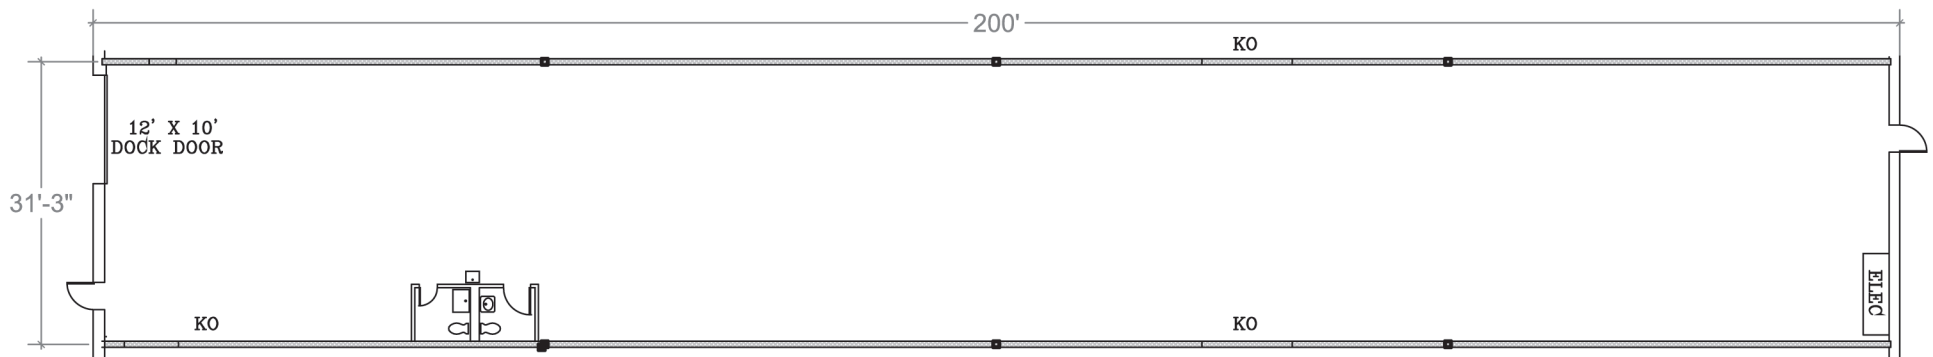

Plan not to scale - this is not a construction document.