


Curtis Business Center


709 East Ordnance Road
Suites 501-503
Baltimore, MD 21226

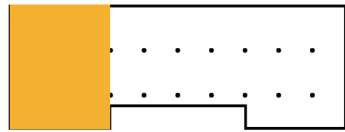

Building Key Plan

Total SF Available - 9,900 SF

Office - 4,046 SF
Warehouse - 5,854 SF

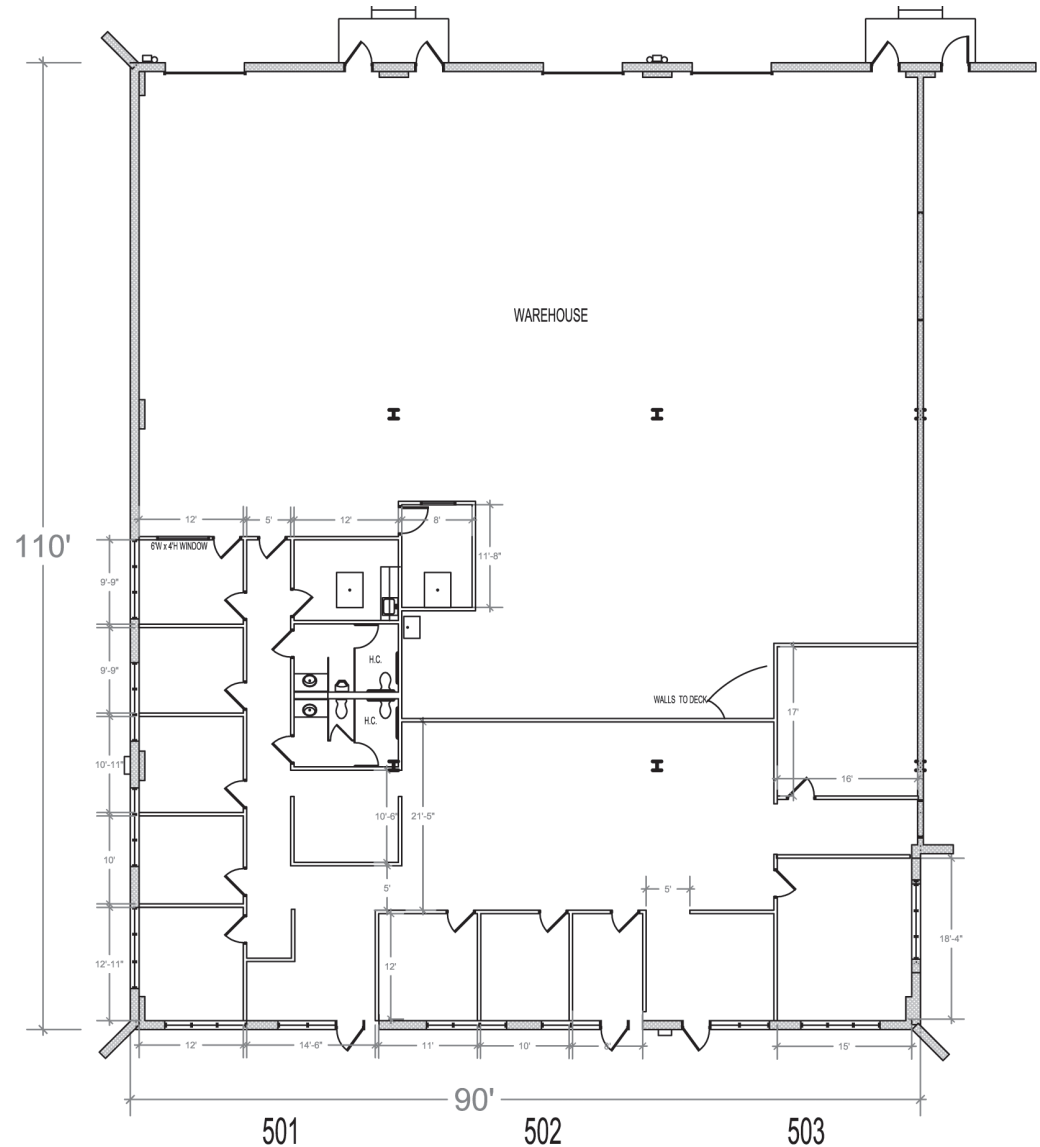

Plan not to scale - this is not a construction document.