

Curtis Business Center


709 East Ordnance Road
Suite 504
Baltimore, MD 21226



Building Key Plan

Total SF Available - 2,700 SF

Office - 1,677 SF
Warehouse - 1,023 SF

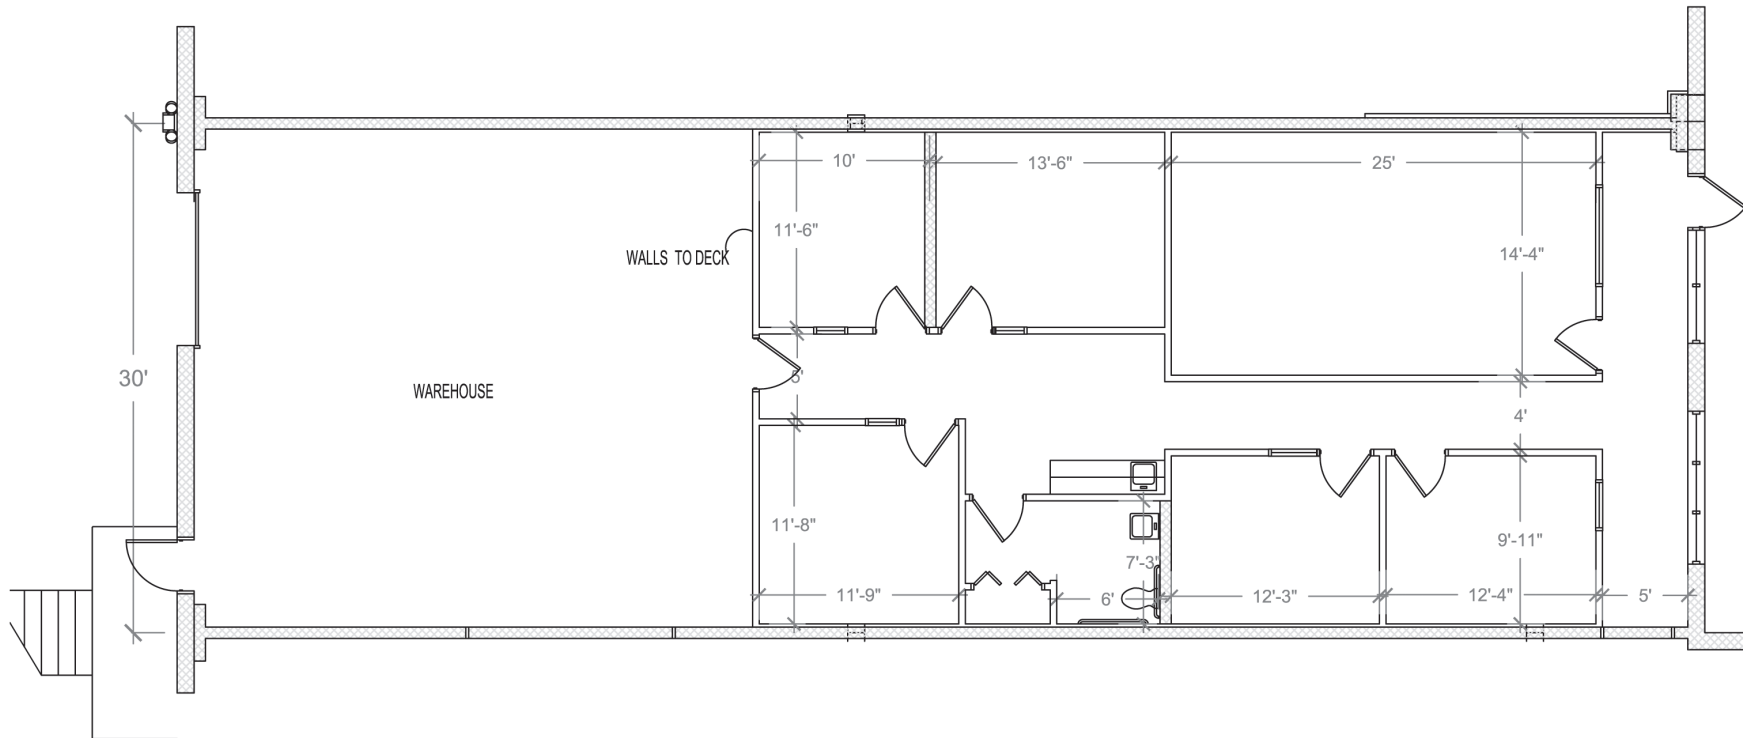

Plan not to scale - this is not a construction document.