



# Baltimore Commons 7471 Candlewood Rd, Ste 104R-107 Hanover, MD 21076


Office Flex Warehouse Distribution Design-Build Green-Build Retail

Nearly 15 million square feet throughout the Baltimore/Washington area



AVAILABLE - 10,722 SF  
0 SF - OFFICE  
10,722 SF - WAREHOUSE  
10,722 SF - TOTAL

*Plan not to scale - this is not a construction document*

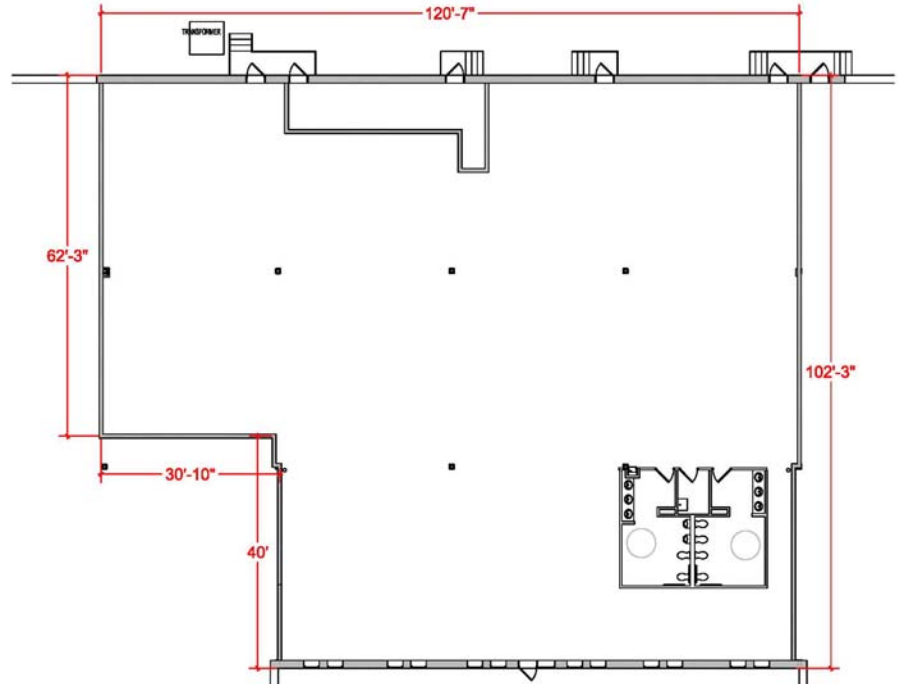

BALTIMORE COMMONS ■ 7471 CANDLEWOOD ROAD, SUITE 104R-107 ■ HANOVER ■ MD 21076