




Building Key Plan

Total SF Office Available  
24,429 RSF

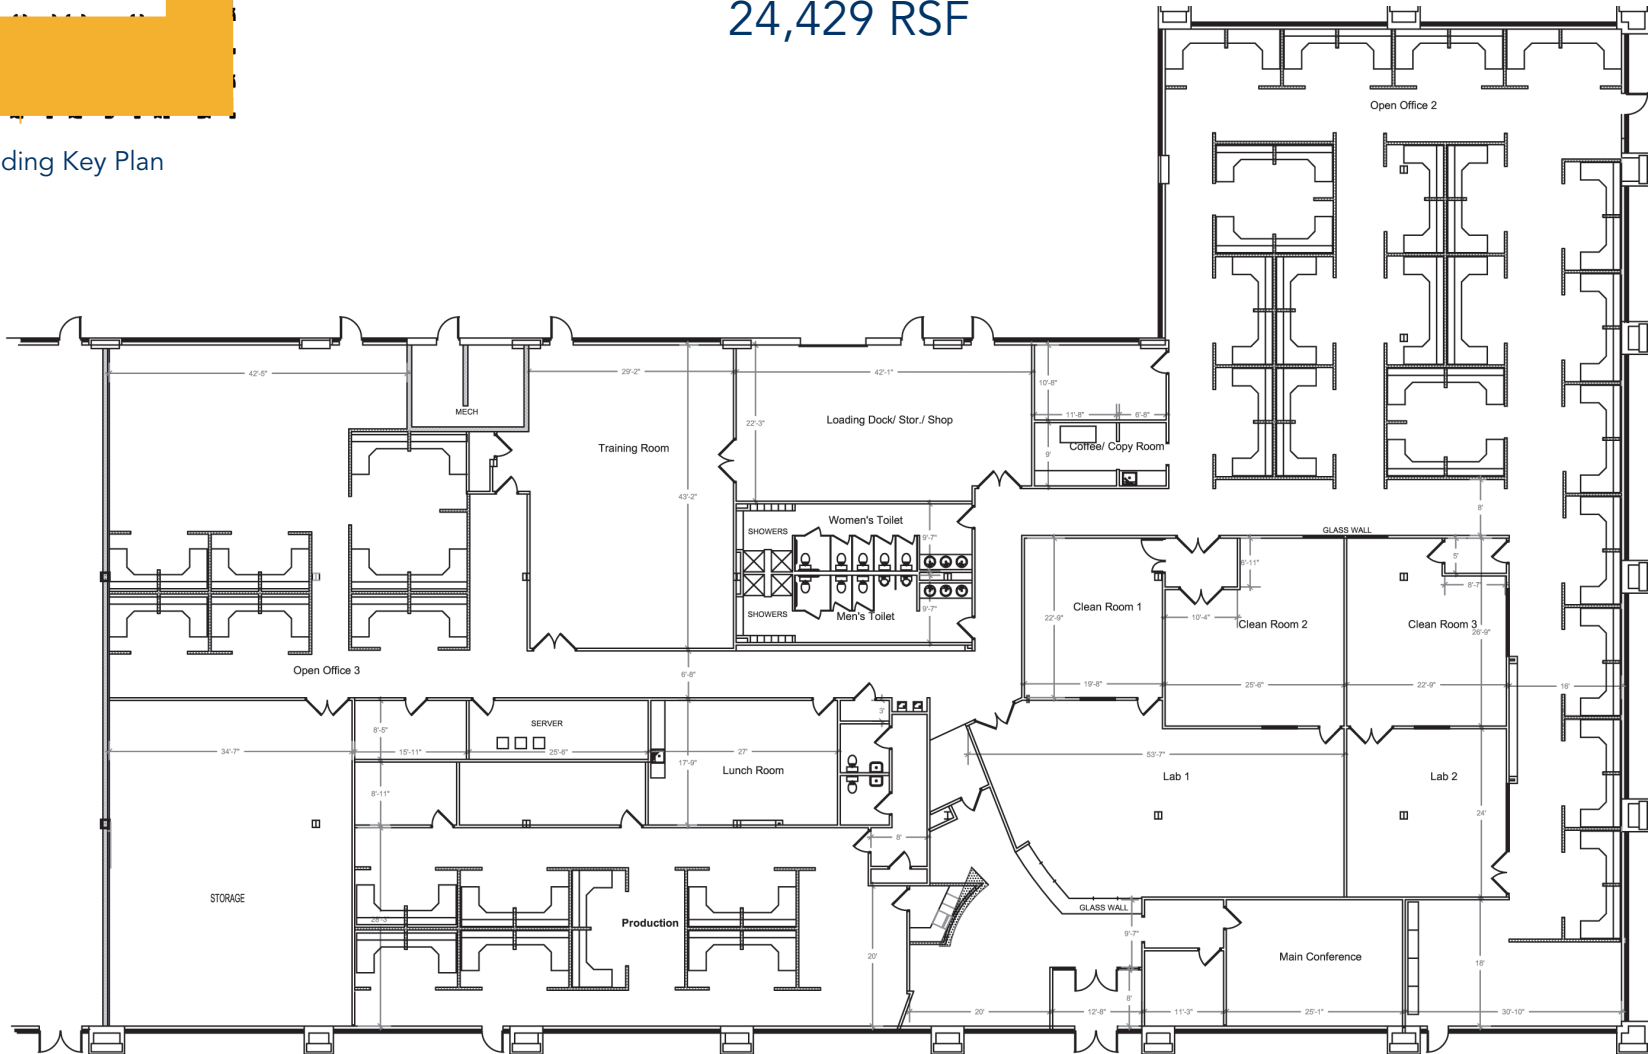

Plan not to scale - this is not a construction document.