




Ashbrook

20098 Ashbrook Place, Suite 220-230


Ashburn, VA 20147

Office Flex Warehouse Distribution Design-Build Green-Build Retail

Nearly 16 million square feet throughout the Baltimore/Washington area

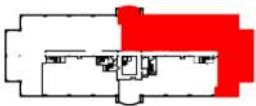

BUILDING KEY PLAN

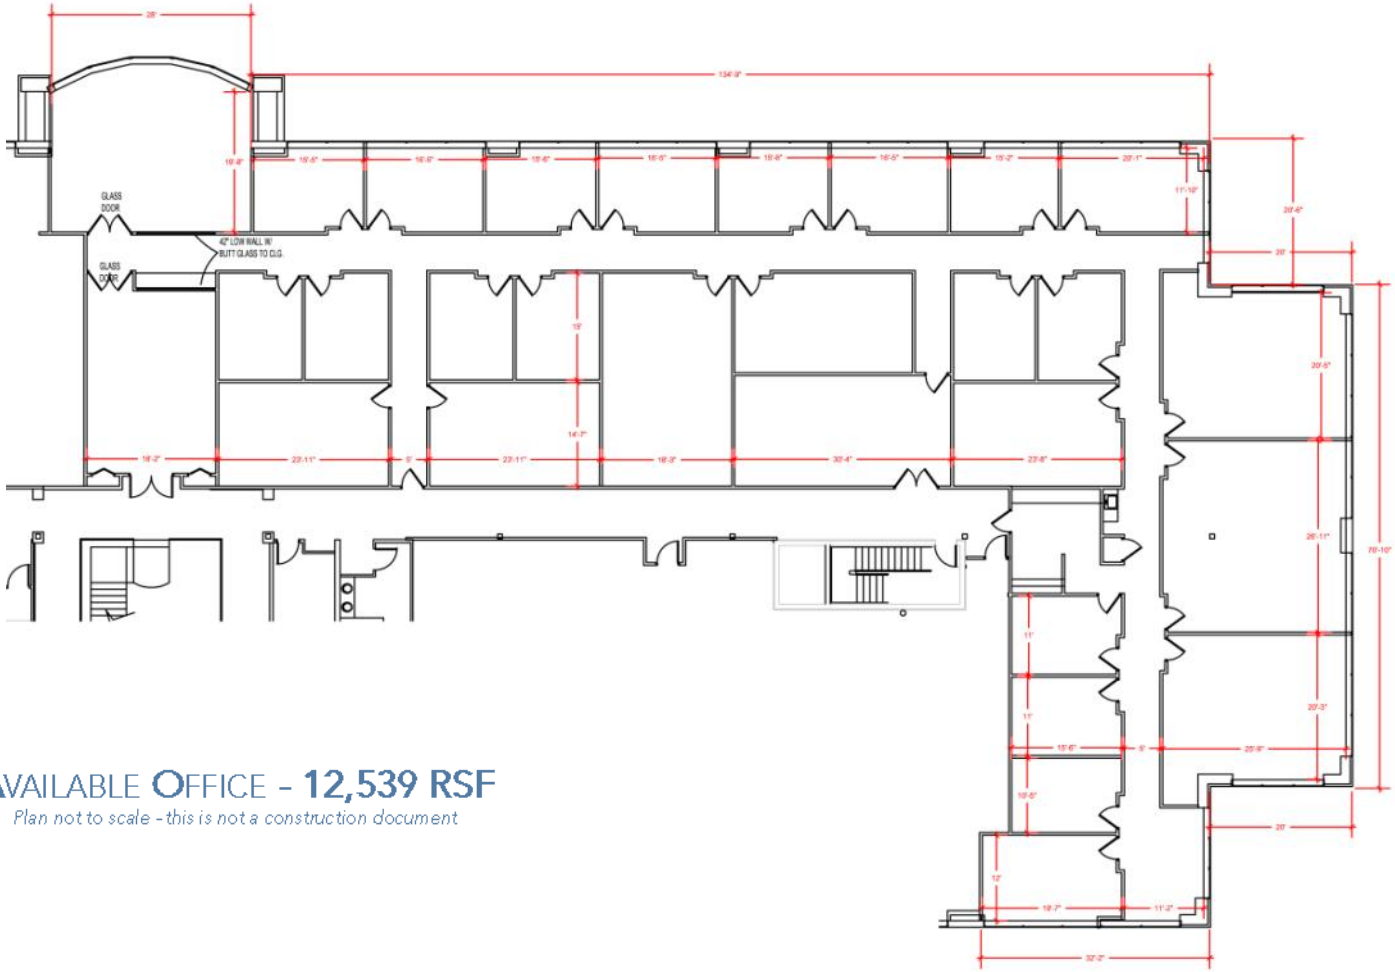

AVAILABLE OFFICE - 12,539 RSF

Plan not to scale - this is not a construction document