



# Annapolis Junction

10810 Guilford Road  
Suites 108-111  
Annapolis Junction, MD 20701

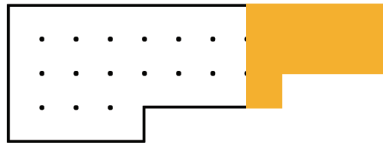

Building Key Plan

Total SF Office Available  
8,100 RSF

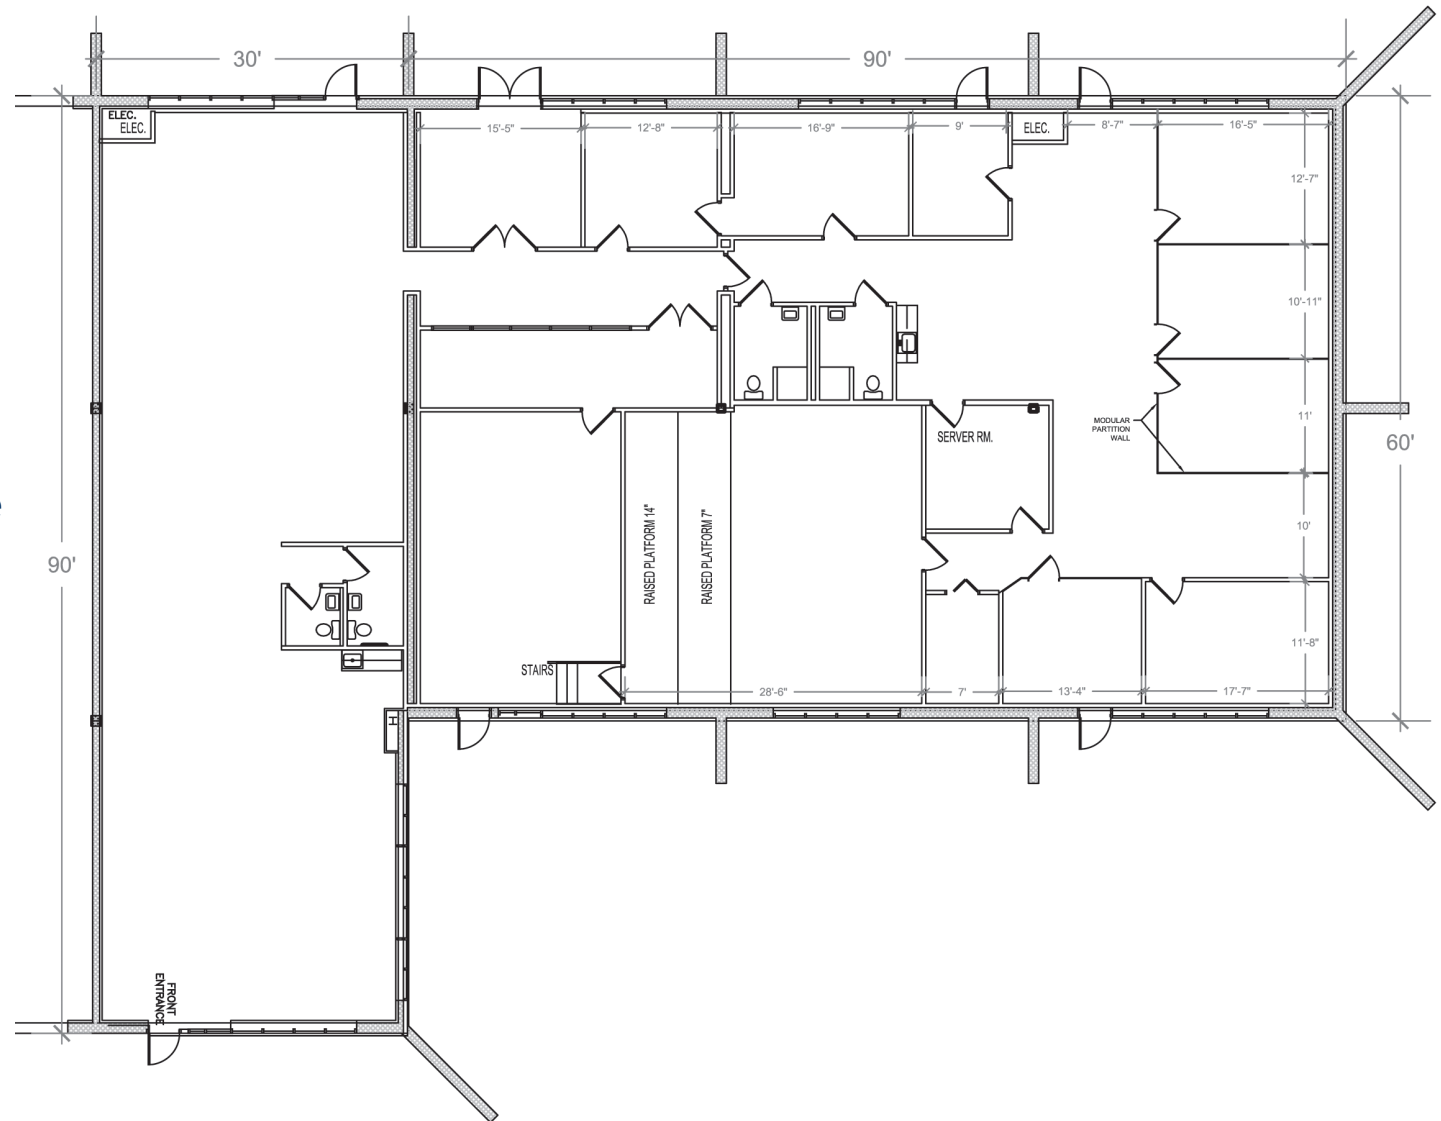

Plan not to scale - this is not a construction document.