


# Annapolis Junction


10840 Guilford Road  
Suites 402 (R) - 403  
Annapolis JCT., MD 20701

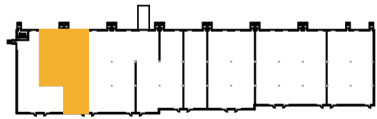

Building Key Plan

Total SF Available - 5,250 SF

Office - 1,210 SF  
Warehouse - 4,040 SF

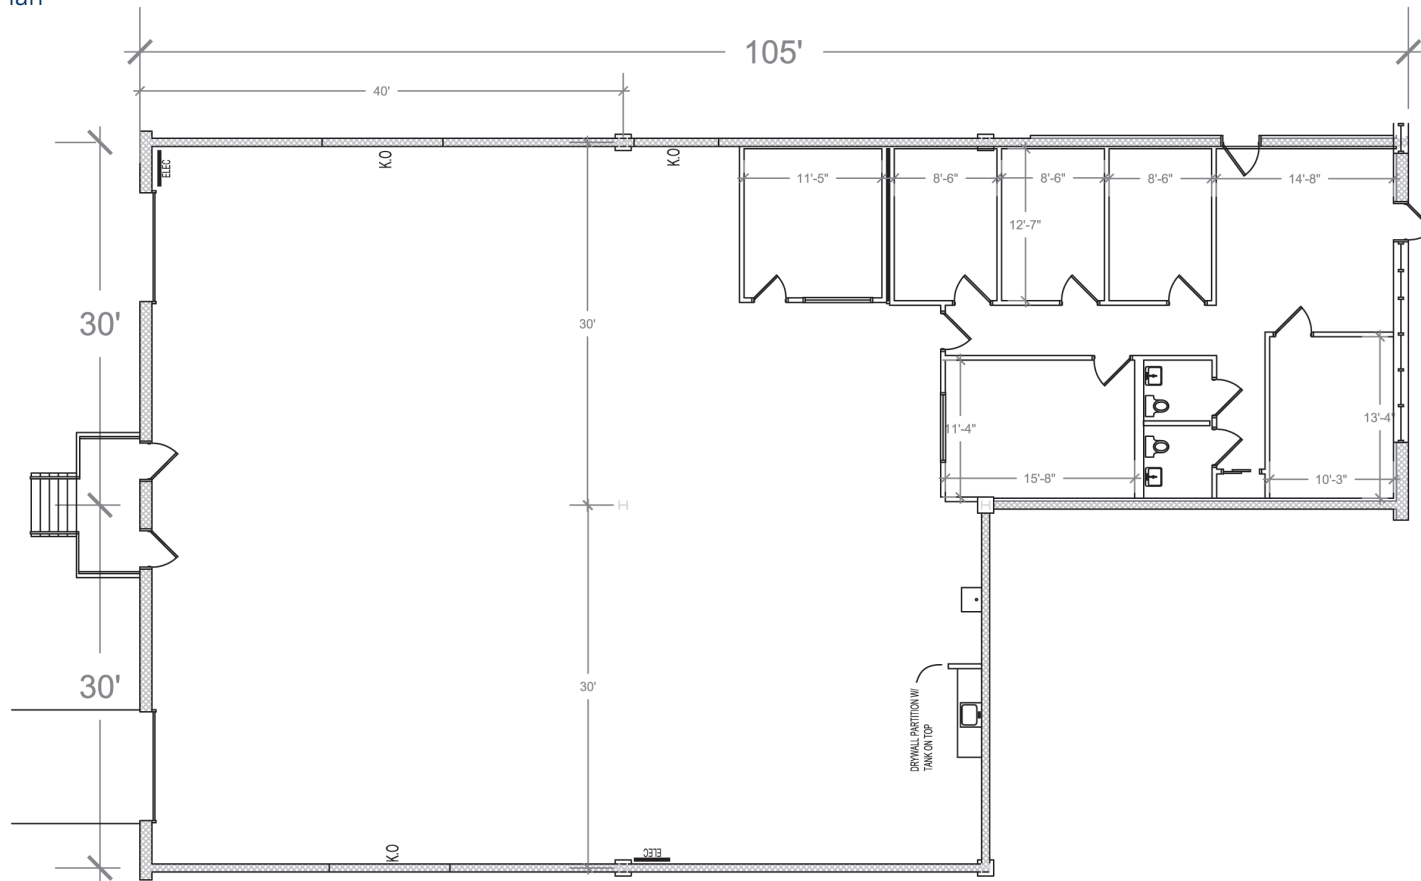

Plan not to scale - this is not a construction document.