


Columbia Corporate Park

8840 Stanford Boulevard
Suite 3120
Columbia, MD 21045



Building Key Plan

Total SF Office Available
1,899 RSF

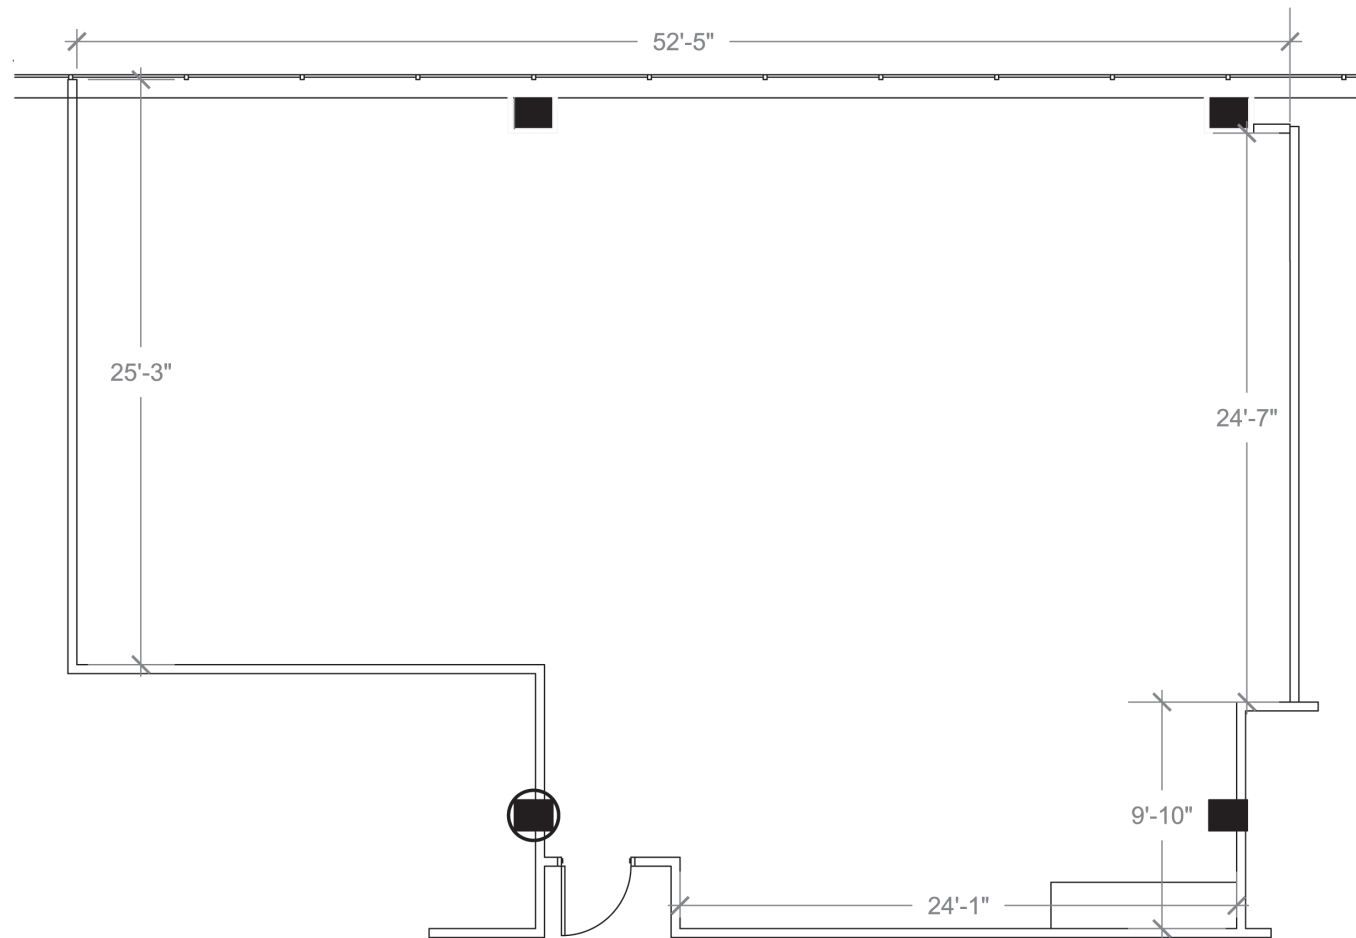

Plan not to scale - this is not a construction document.