


# Columbia Corporate Park

8840 Stanford Boulevard  
Suite 3600  
Columbia, MD 21045



Building Key Plan

Total SF Office Available  
2,193 RSF

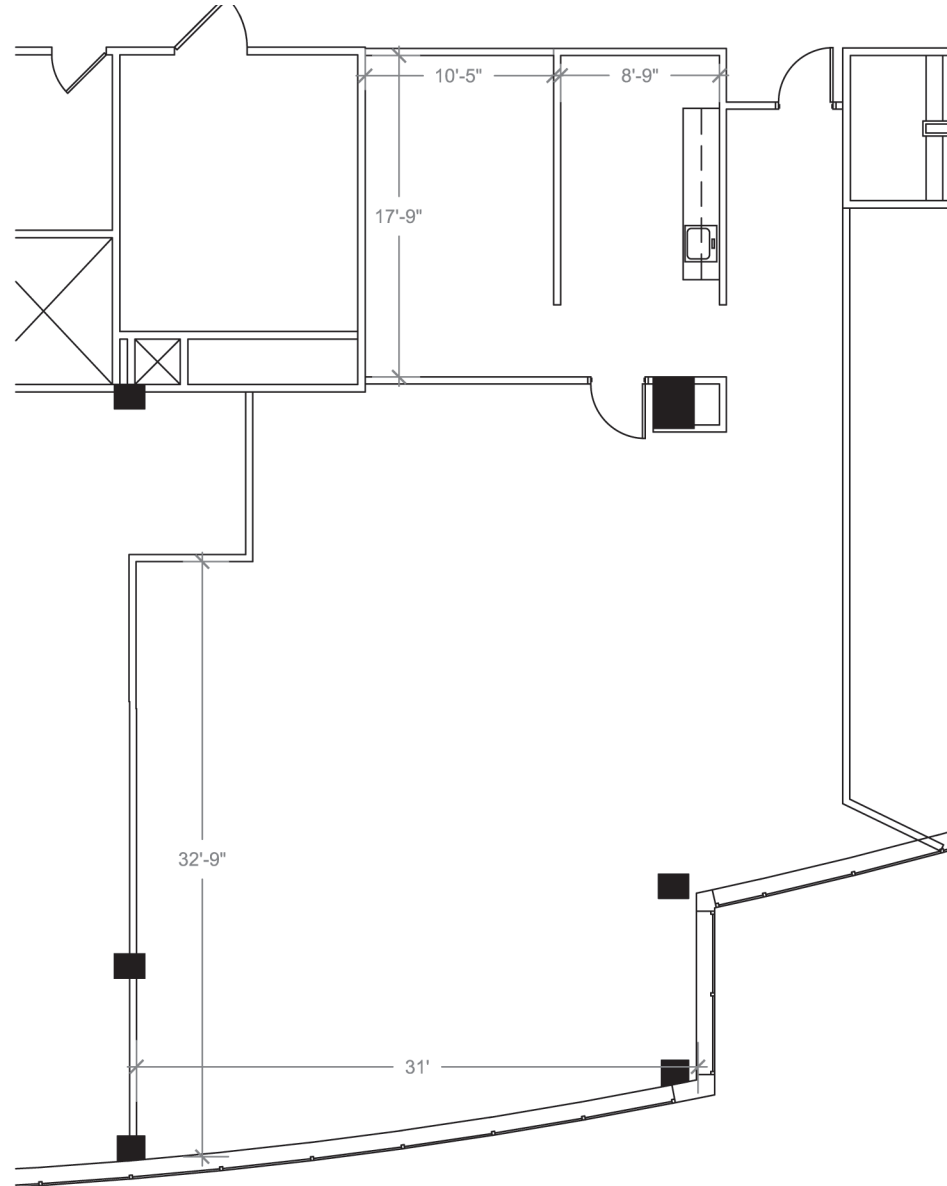

*Plan not to scale - this is not a construction document.*