



# Columbia Corporate Park

8830 Stanford Boulevard  
Suite 402  
Columbia, MD 21045

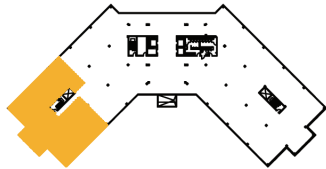

Building Key Plan

Total SF Office Available  
6,552 RSF

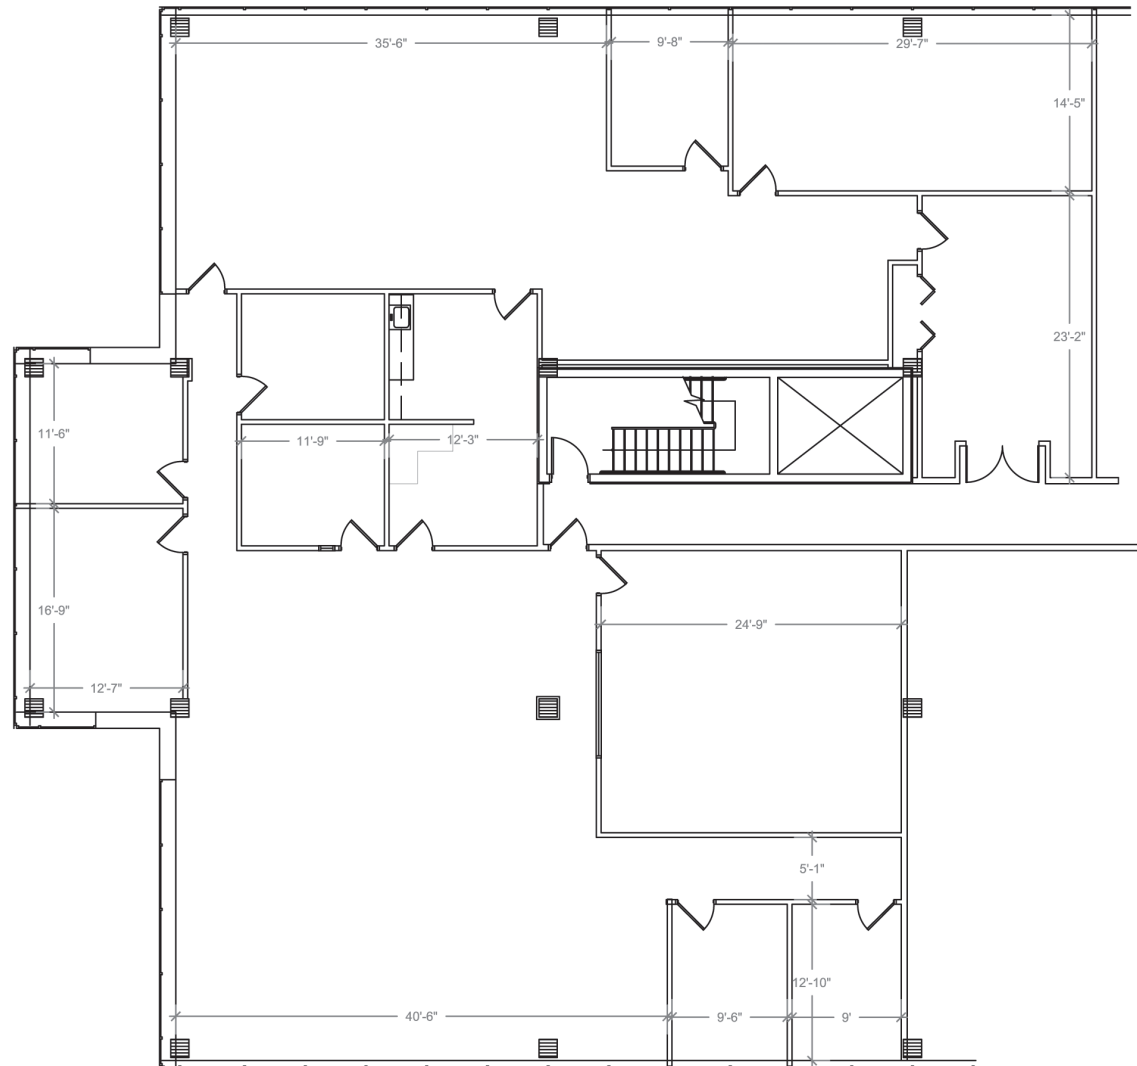

*Plan not to scale - this is not a construction document.*