



Columbia Corporate Park

8830 Stanford Boulevard
Suites 404-405
Columbia, MD 21045

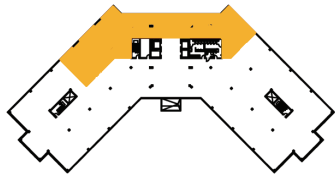

Building Key Plan

Total SF Office Available
7,197 RSF

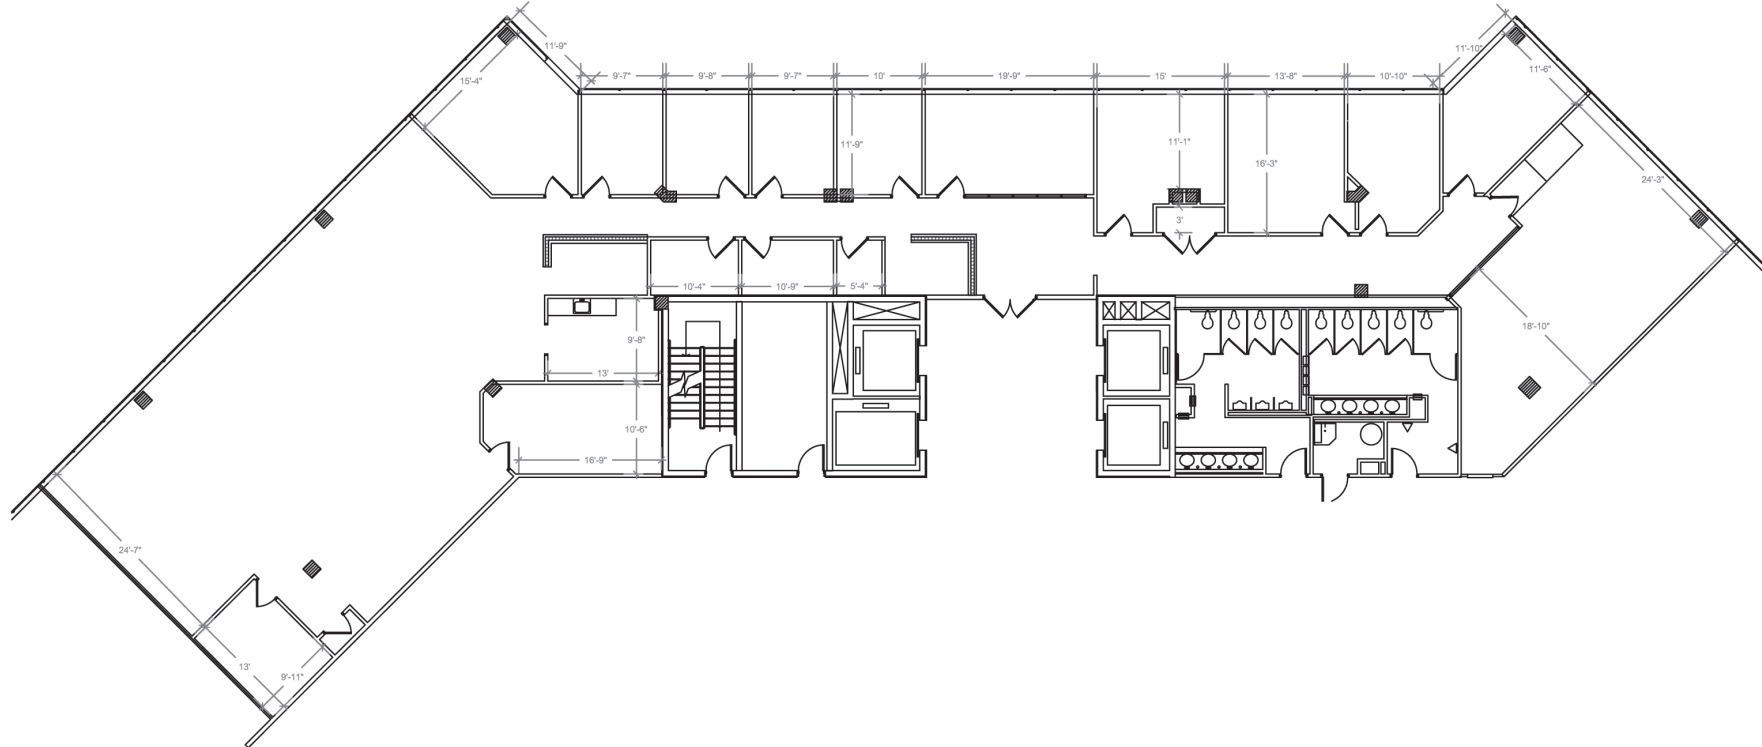

Plan not to scale - this is not a construction document.