


Columbia Corporate Park

8825 Stanford Boulevard
Suite 308
Columbia, MD 21045



Building Key Plan

Total SF Office Available
3,993 RSF

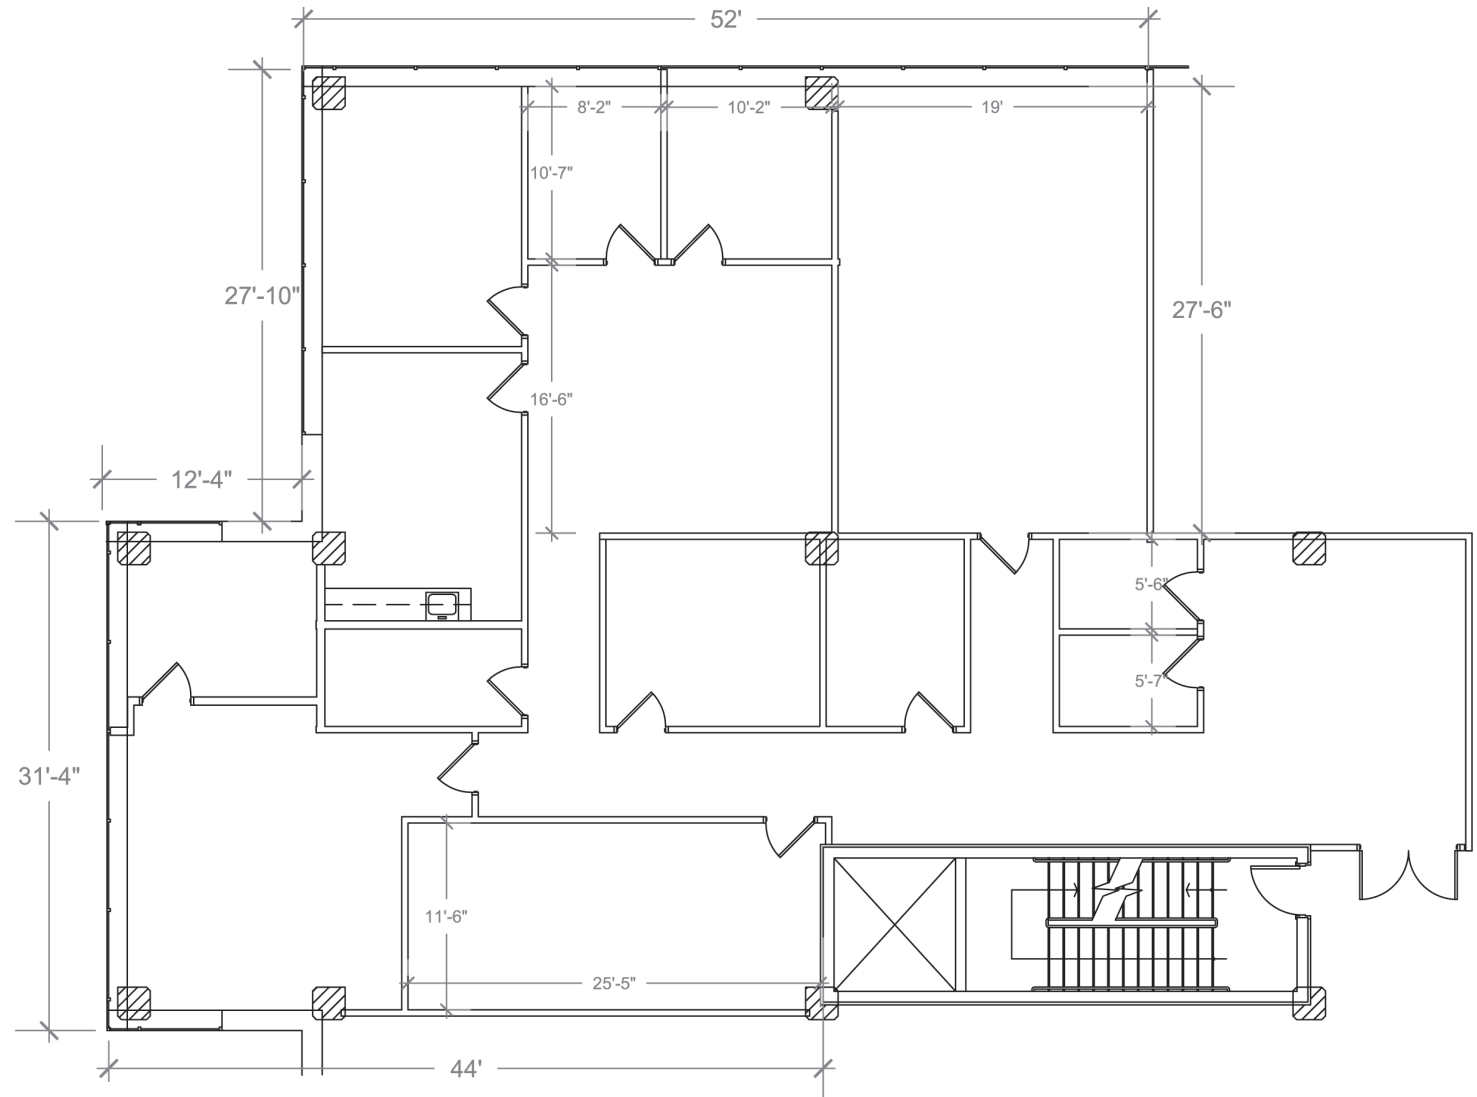

Plan not to scale - this is not a construction document.