


Beaumeade Park


Building 5, Suites 100-110
Ashburn, VA 20147

Total SF Warehouse Space Available
14,020 SF

* Includes % of Meter Room

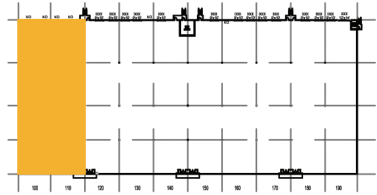

Building Key Plan

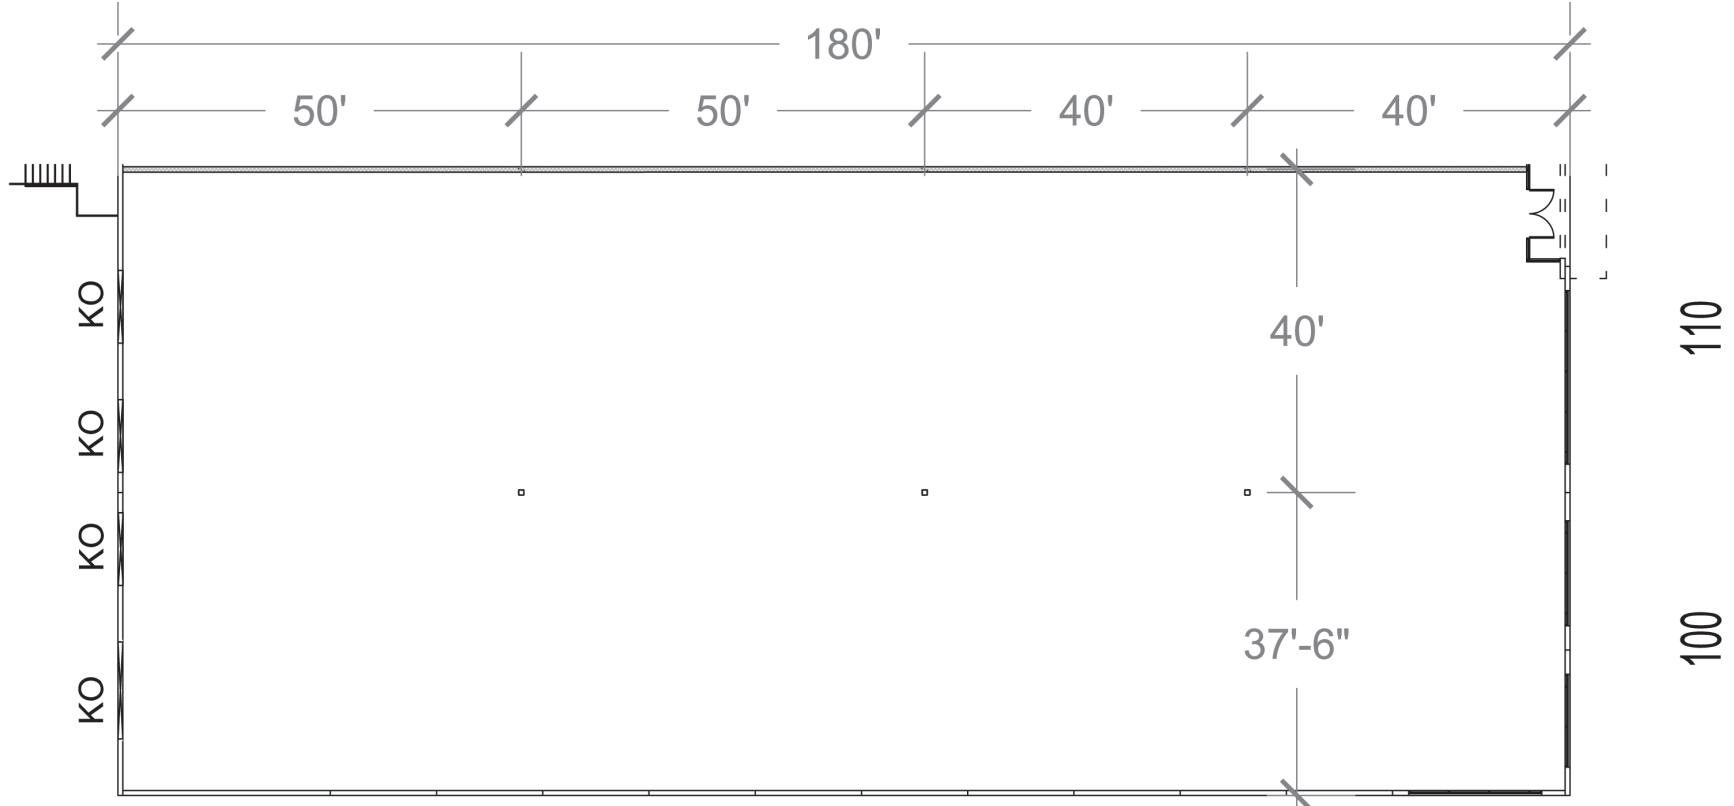

Plan not to scale - this is not a construction document.