


Energy Parkway

7600 Energy Parkway
Suites 103-106
Baltimore, MD 21226



Building Key Plan

Total SF Warehouse Available
3,600 SF

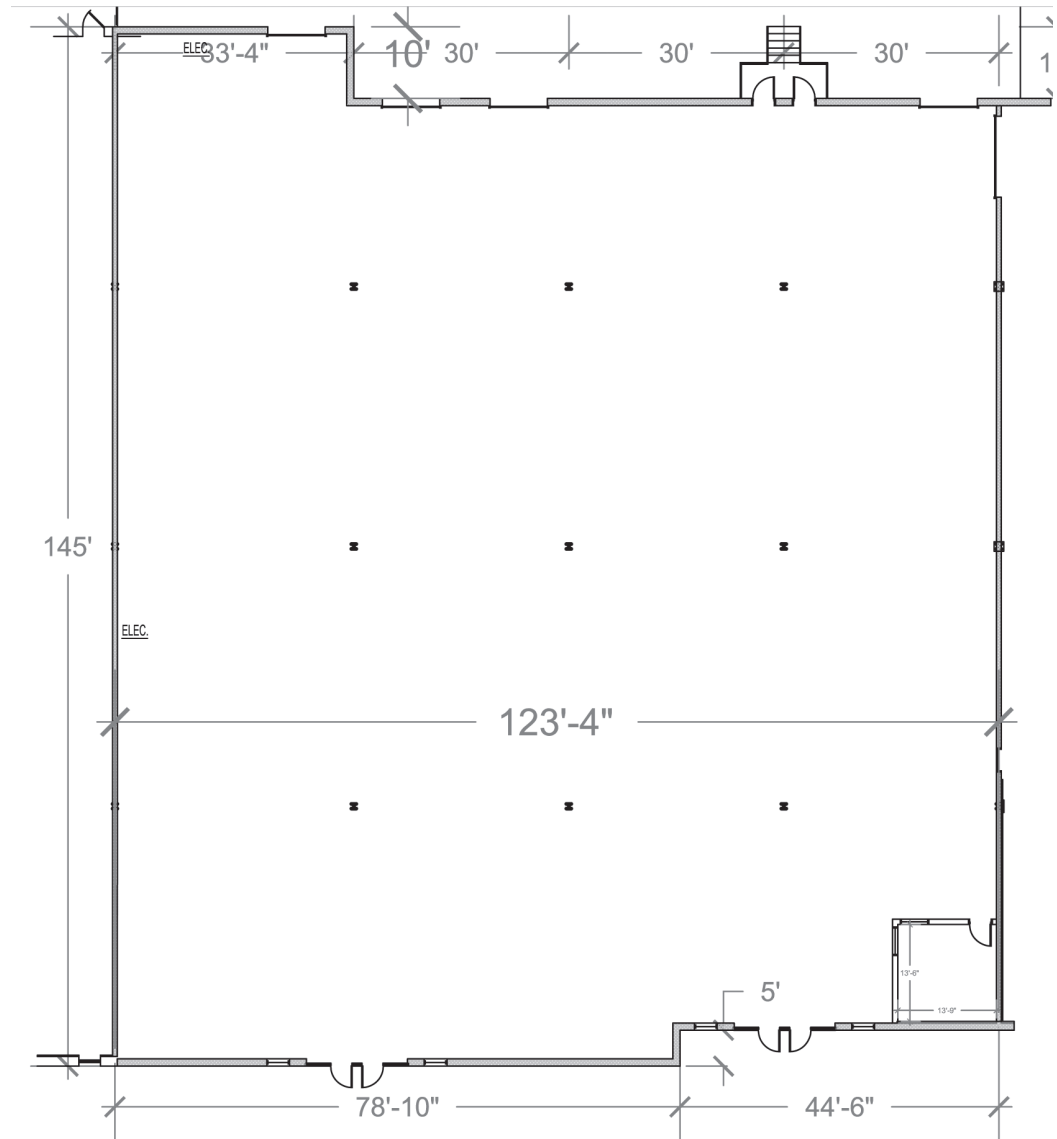

Plan not to scale - this is not a construction document.