


Beltway Business Park


1730 Twin Springs Road
Suite 218
Baltimore, MD 21227

Total SF Available - 3,000 SF

Office - 456 SF
Warehouse - 2,544 SF

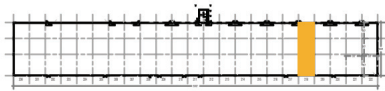

Building Key Plan

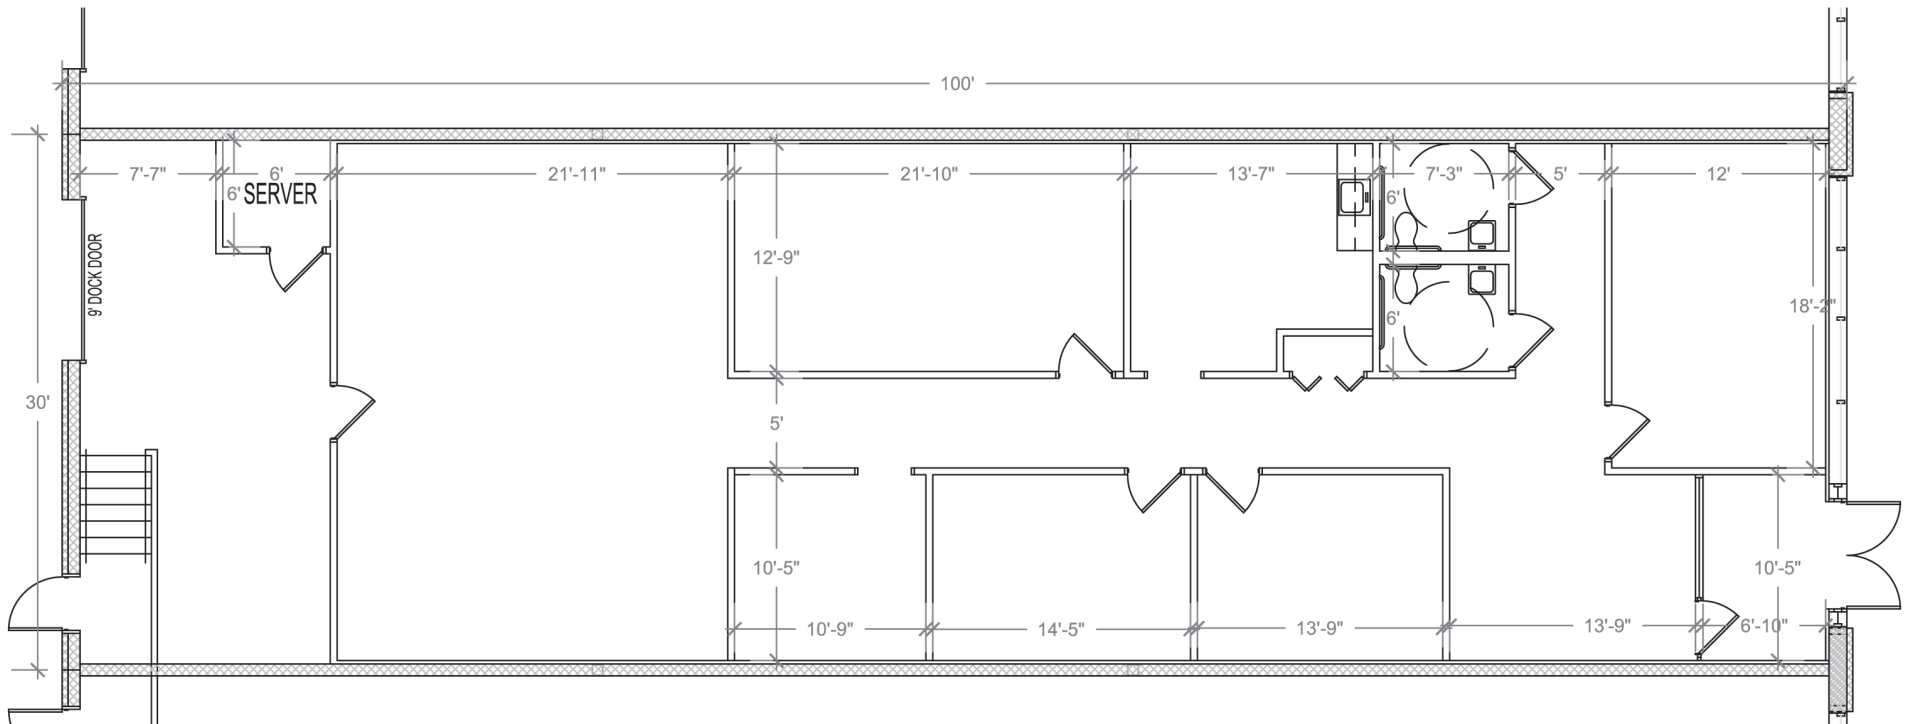

Plan not to scale - this is not a construction document.