


# Golden Ring I


7008 (R) Golden Ring Road  
Baltimore, MD 21237

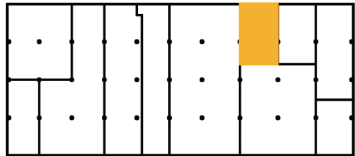

Building Key Plan

Total SF Available - 1,950 SF

Office - 356 SF  
Warehouse - 1,594 SF

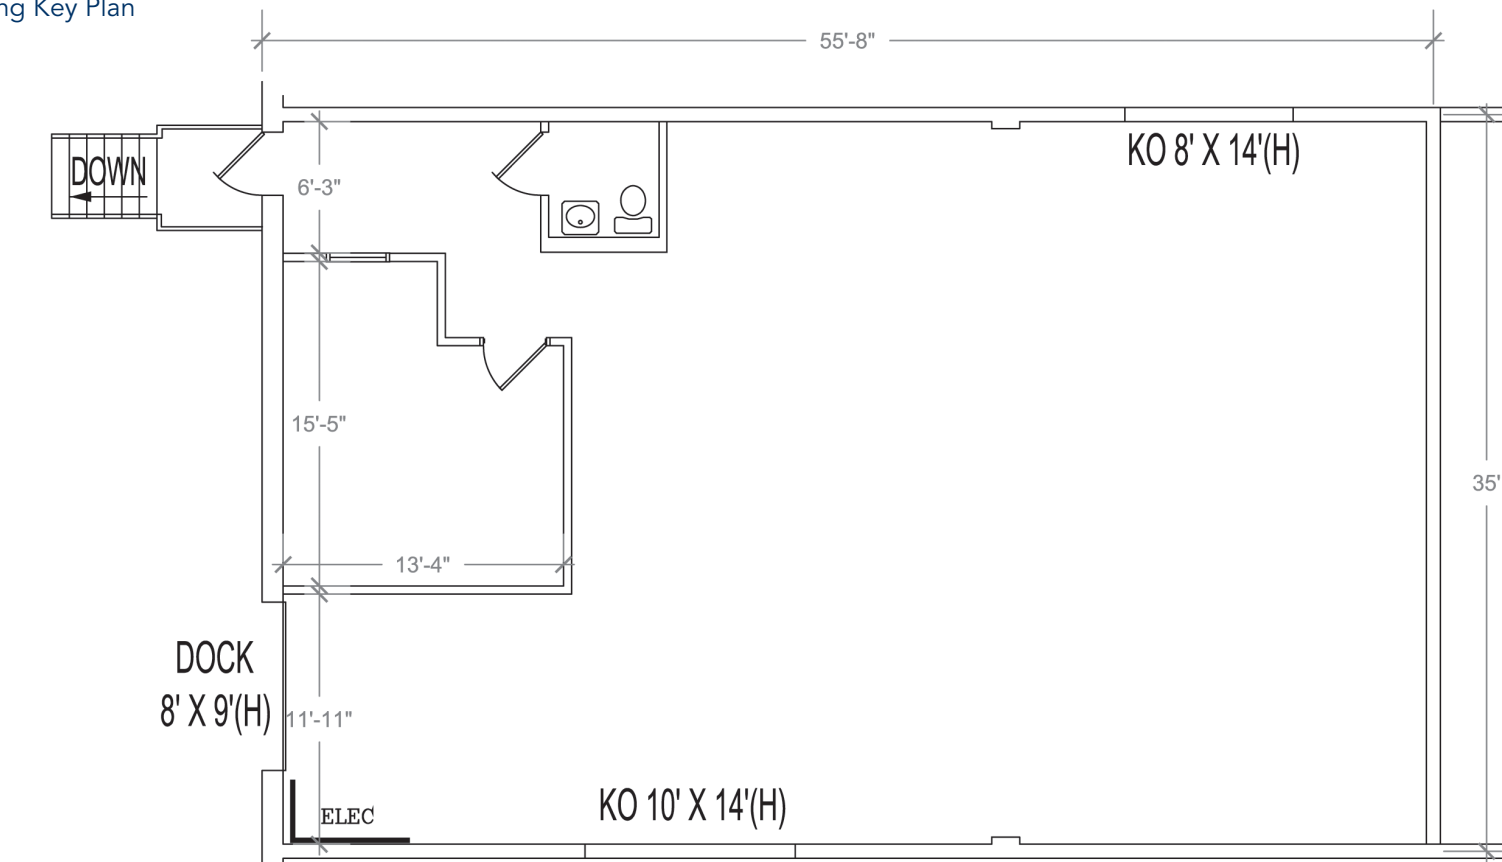

Plan not to scale - this is not a construction document.