


# Golden Ring I


7034-7038 Golden Ring Road  
Baltimore, MD 21237

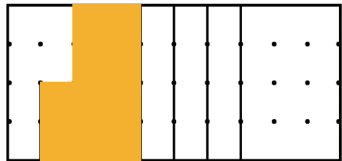

Building Key Plan

Total SF Available - 10,500 SF

Office - 5,800 SF  
Warehouse - 4,700 SF

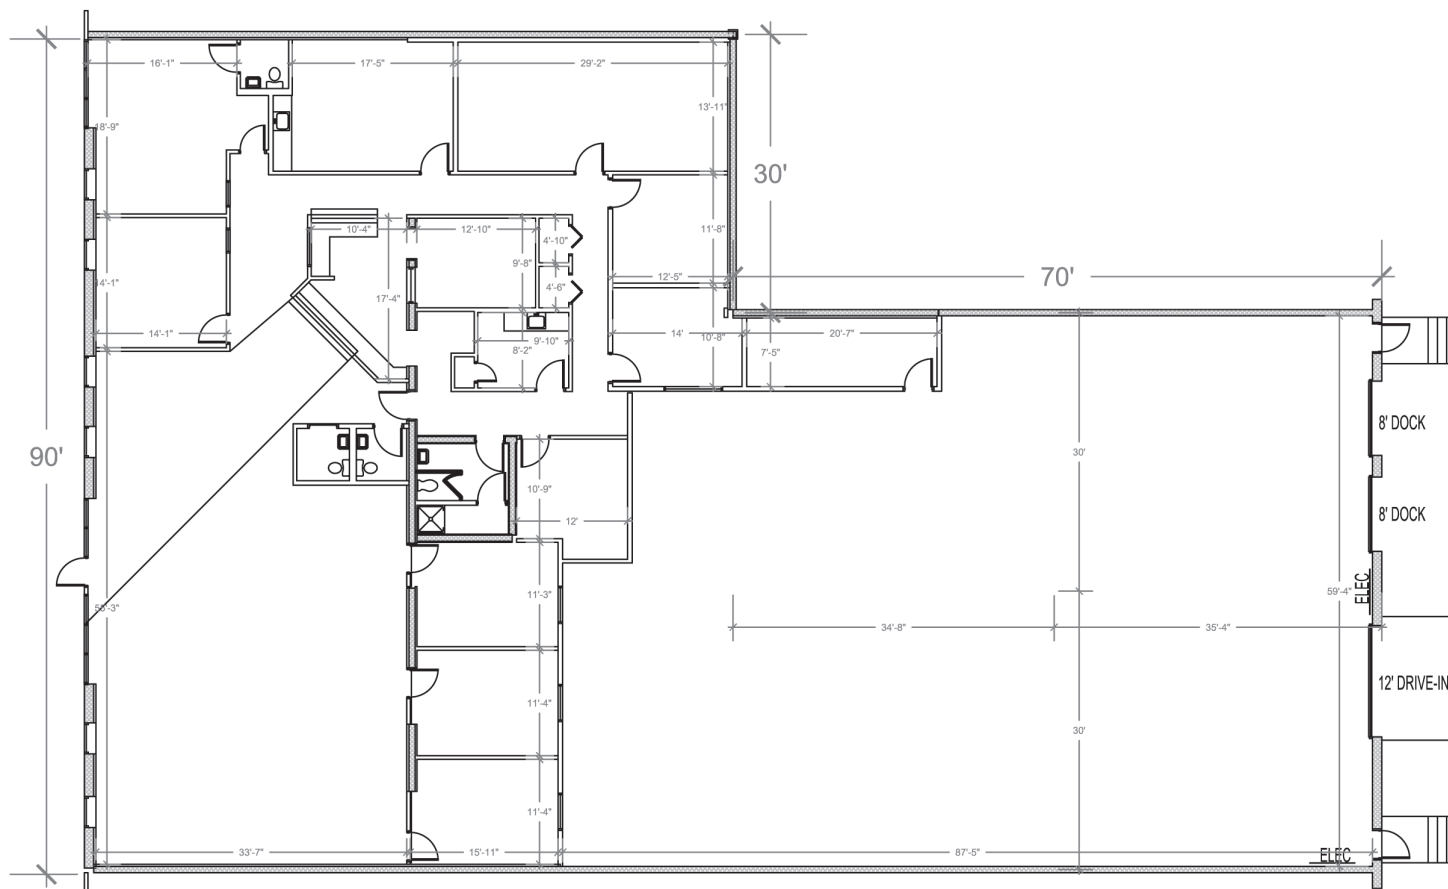

Plan not to scale - this is not a construction document.