


Forty West Auto Park

6431 Baltimore National Pike
Suite 104-106
Catonsville, MD 21228



Building Key Plan

Total SF Retail Available
3,100 RSF

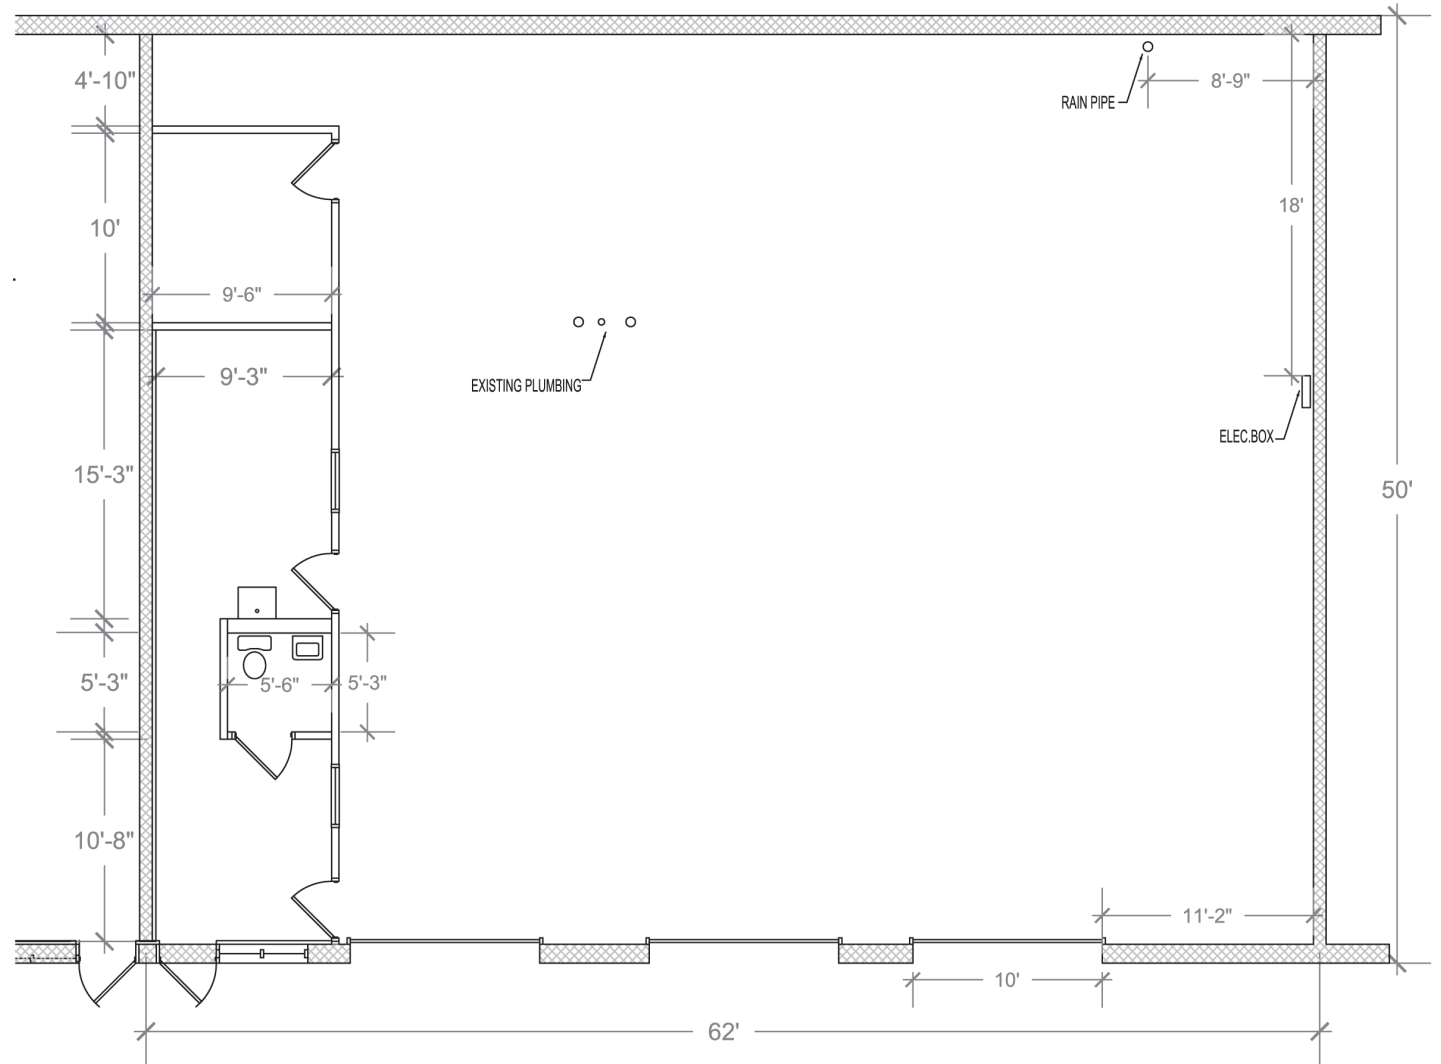

Plan not to scale - this is not a construction document.