




Annapolis Business Center - Bldg. 3 1981 Moreland Parkway, Bay 2 Annapolis, MD 21401

Office Flex Warehouse Distribution Design-Build Green-Build Retail

Nearly 15 million square feet throughout the Baltimore/Washington area

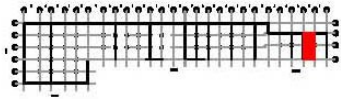

BUILDING KEY PLAN

AVAILABLE - 1,950 SF

0 SF - OFFICE
1,950 SF - WAREHOUSE
1,950 SF - TOTAL

Plan not to scale - this is not a construction document

