




Annapolis Business Center - Bldg. 4A

1981 Moreland Parkway, Bay 1
Annapolis, MD 21401

Office Flex Warehouse Distribution Design-Build Green-Build Retail

Nearly 15 million square feet throughout the Baltimore/Washington area

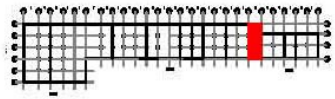

BUILDING KEY PLAN

AVAILABLE - 3,150 SF

0 SF - OFFICE
3,150 SF - WAREHOUSE
3,150 SF - TOTAL

Plan not to scale - this is not a construction document

