


Berger Road


9525 Berger Road, Suite G-K
Columbia, MD

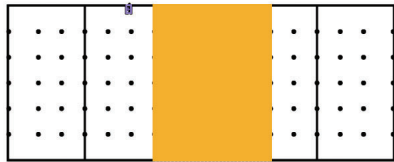

Building Key Plan

Total Available
30,000 SF

Office - 4,8189 SF
Warehouse - 25,181 SF

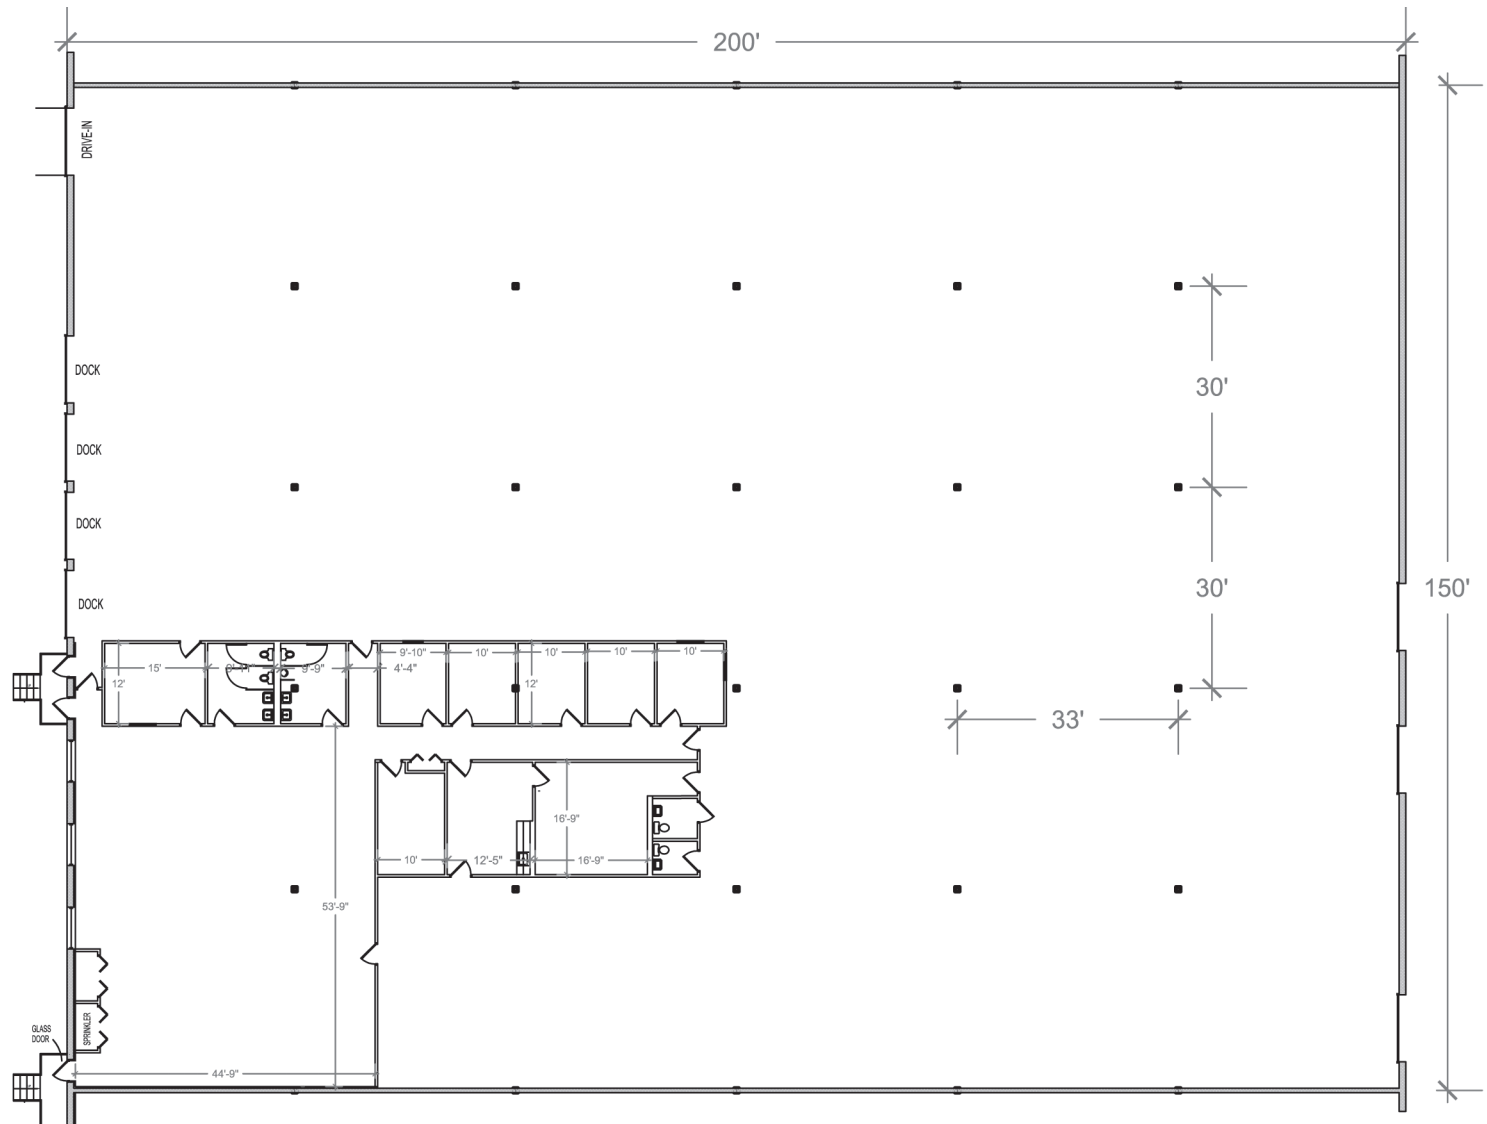


Plan not to scale - this is not a construction document.

Berger Road

9525 Berger Road, Suite G-K
Columbia, MD

Total Office
Available
4,819 SF

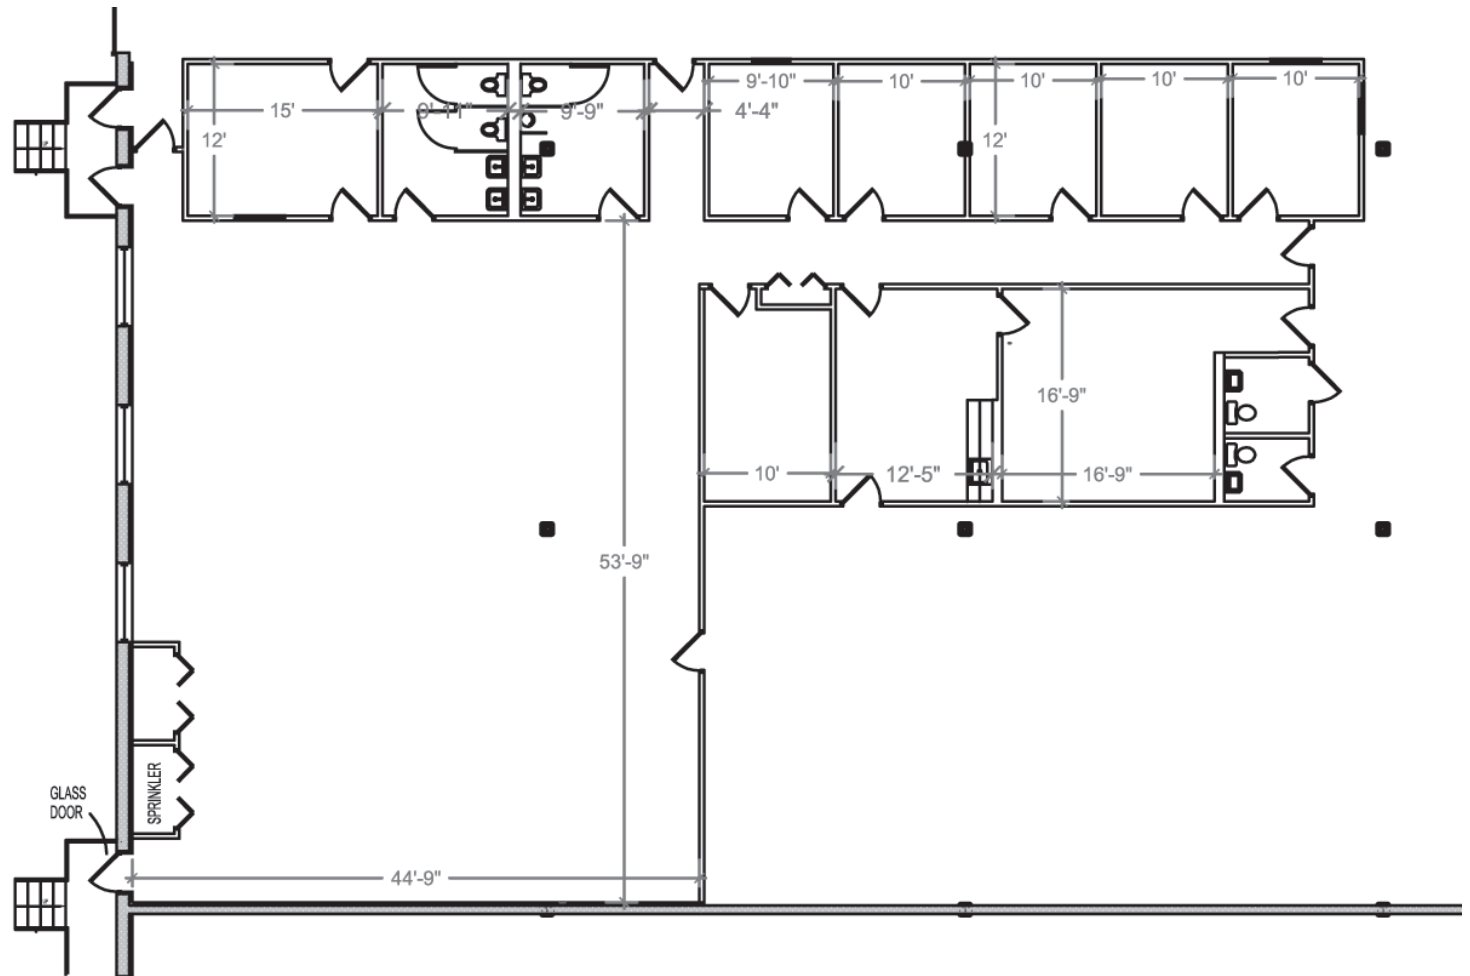

Plan not to scale - this is not a construction document.