



# 729 East Pratt

250 S. President Street  
Suite 3200  
Baltimore, MD 21202

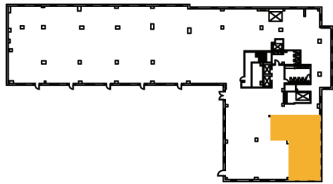

Building Key Plan

Total SF Office Available  
1,411 RSF

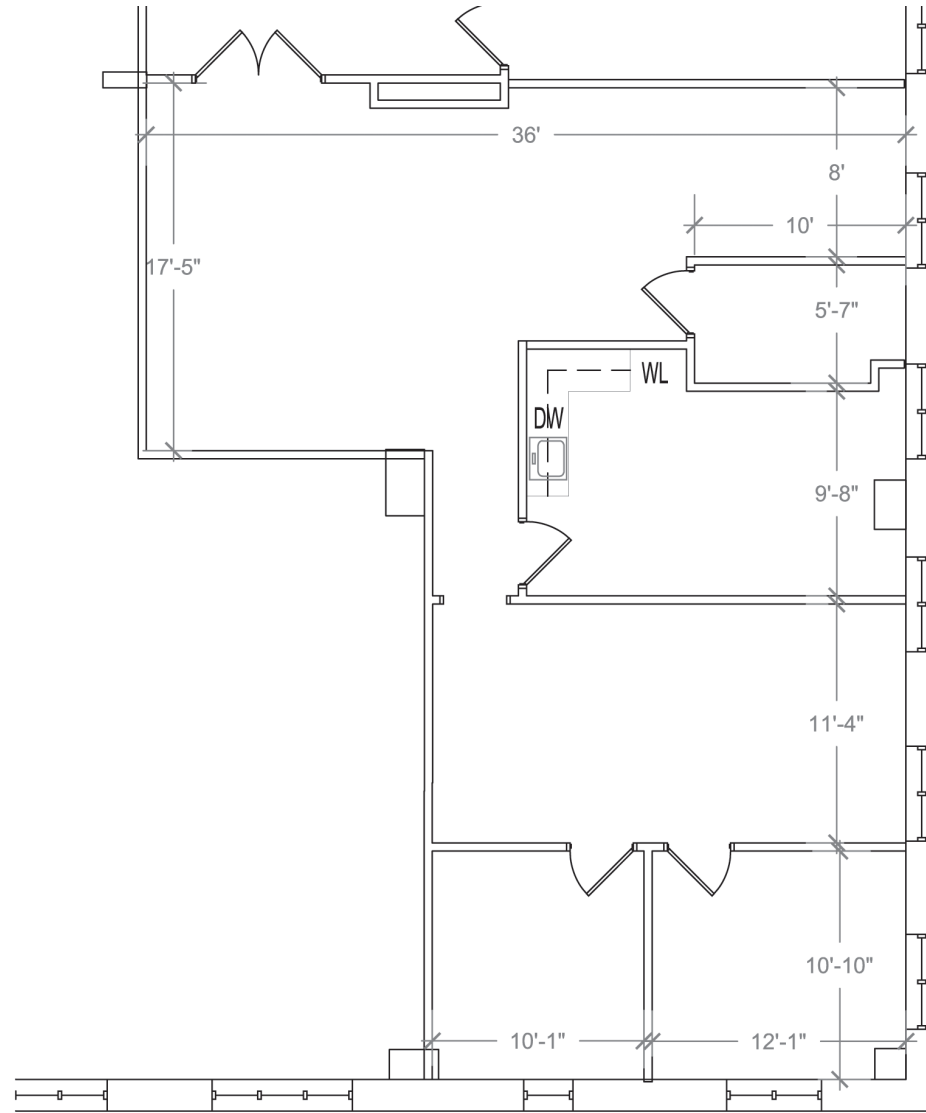

Plan not to scale - this is not a construction document.