


729 East Pratt


729 East Pratt Street
Suite 220
Baltimore, MD 21202

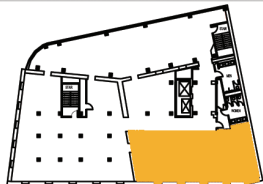

LEVEL TWO

Building Key Plan

Total SF Office Available
1,676 RSF

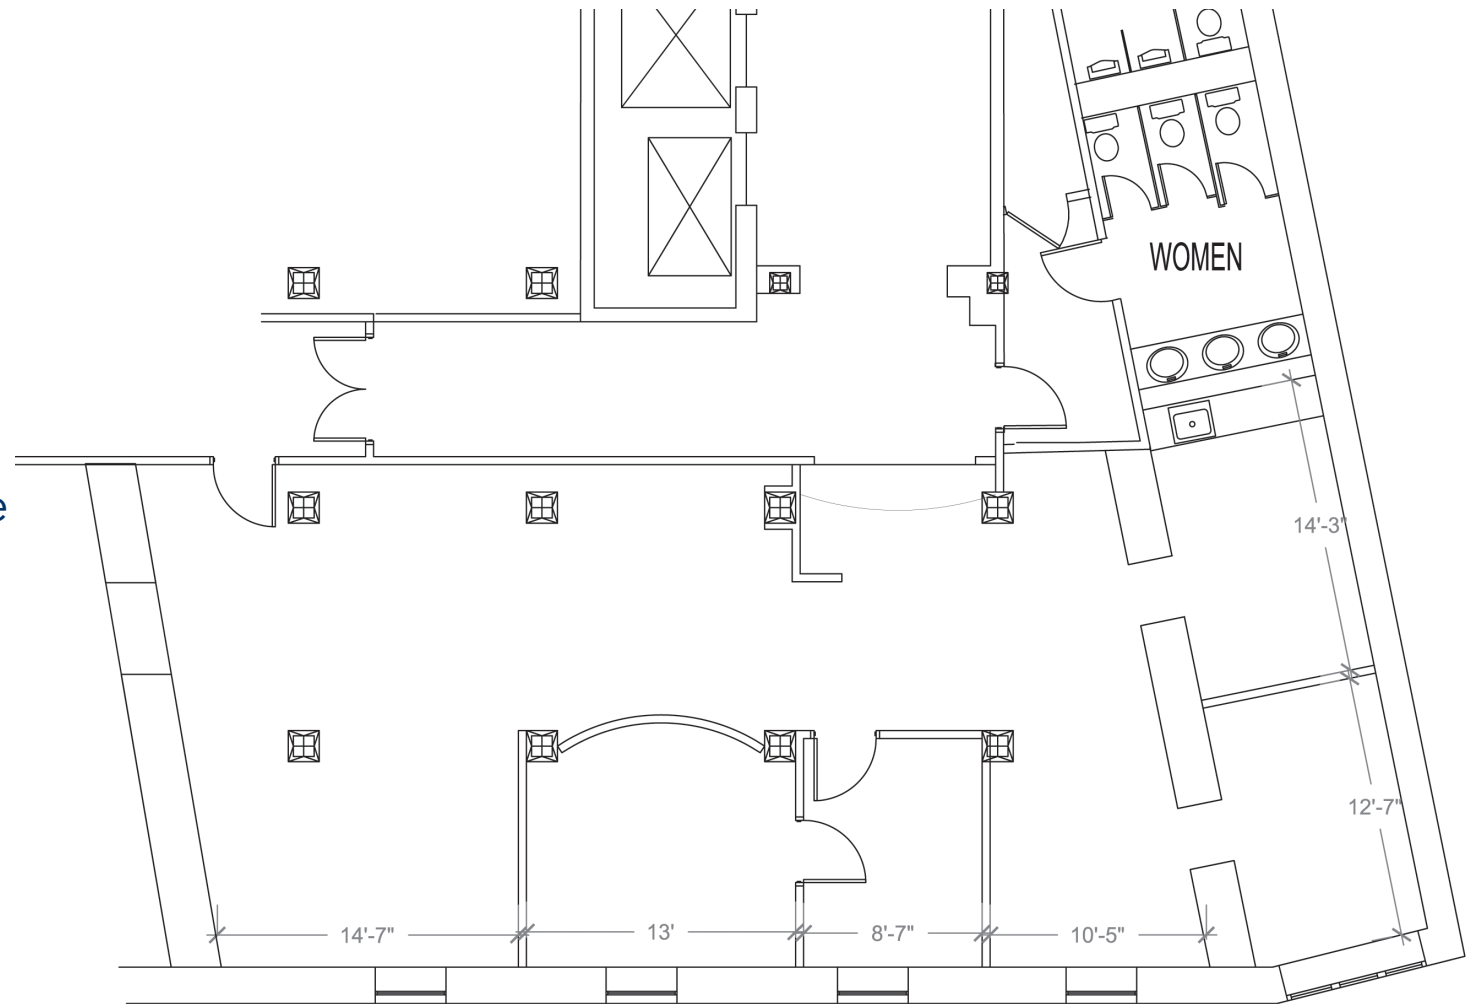

Plan not to scale - this is not a construction document.