




729 East Pratt Street Suite 960-990 Baltimore, MD 21202

Office Flex Warehouse Distribution Design-Build Green-Build Retail

Nearly 15 million square feet throughout the Baltimore/Washington area

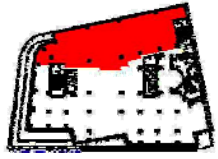

BUILDING KEY PLAN

AVAILABLE - 2,319 SF

2,319 SF - OFFICE
0 SF - WAREHOUSE
2,319 SF - TOTAL

Plan not to scale - this is not a construction document

