



Columbia Corporate Park 100

6011 University Boulevard
Suite 100
Ellicott City, MD 21043

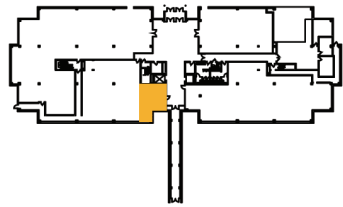

Building Key Plan

Total SF Office Available
648 RSF

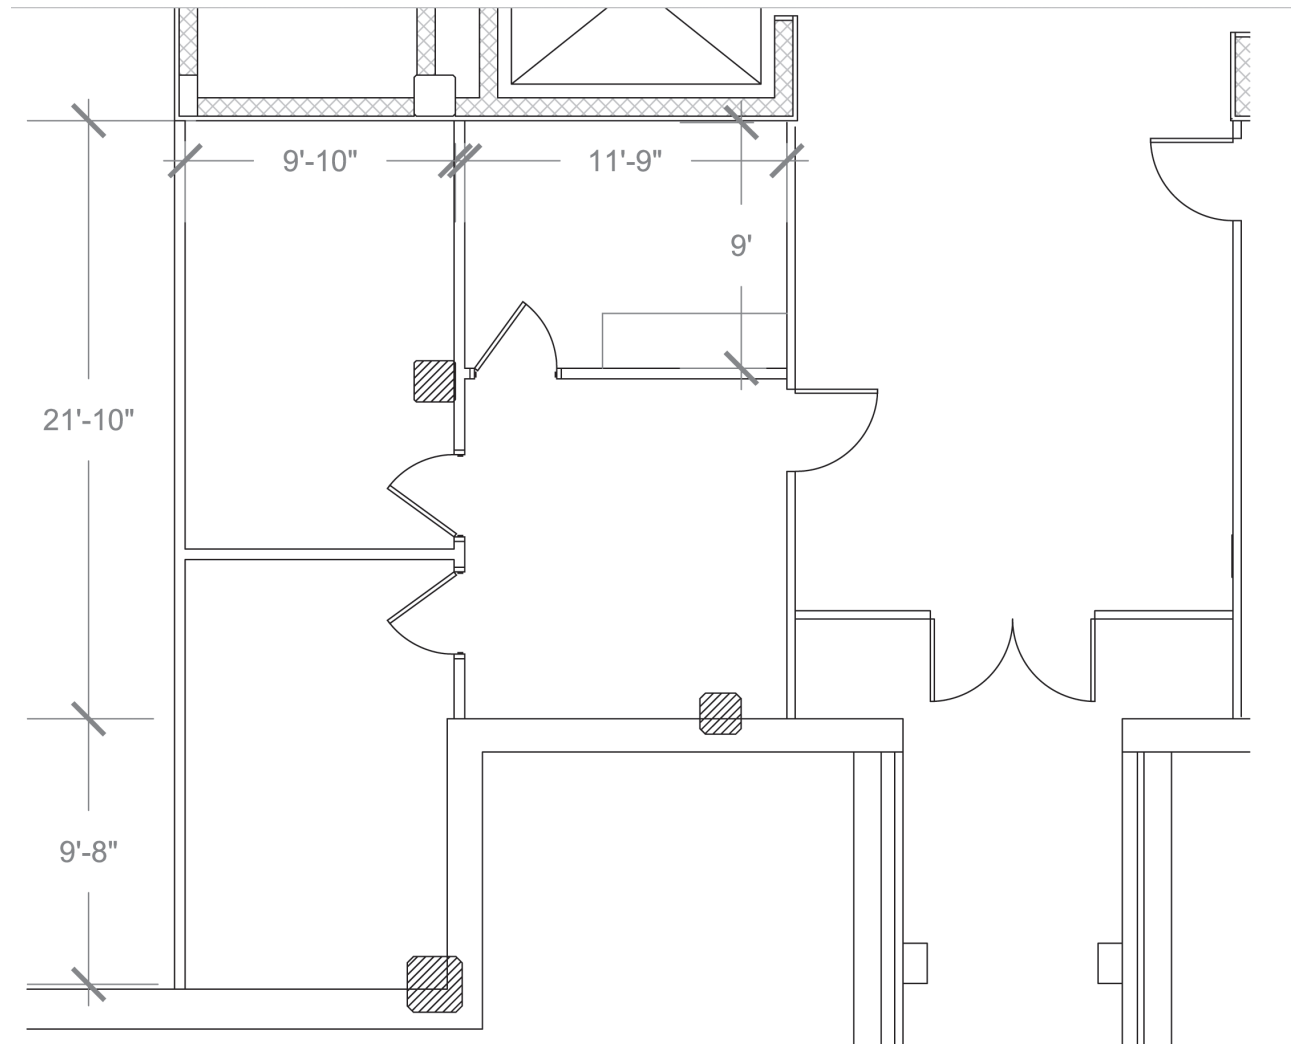

Plan not to scale - this is not a construction document.