



# Columbia Corporate Park 100

6011 University Boulevard  
Suite 180  
Ellicott City, MD 21043

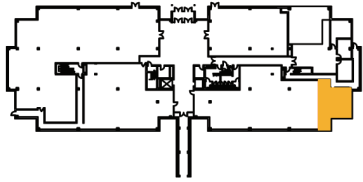

Building Key Plan

Total SF Office Available  
844 RSF

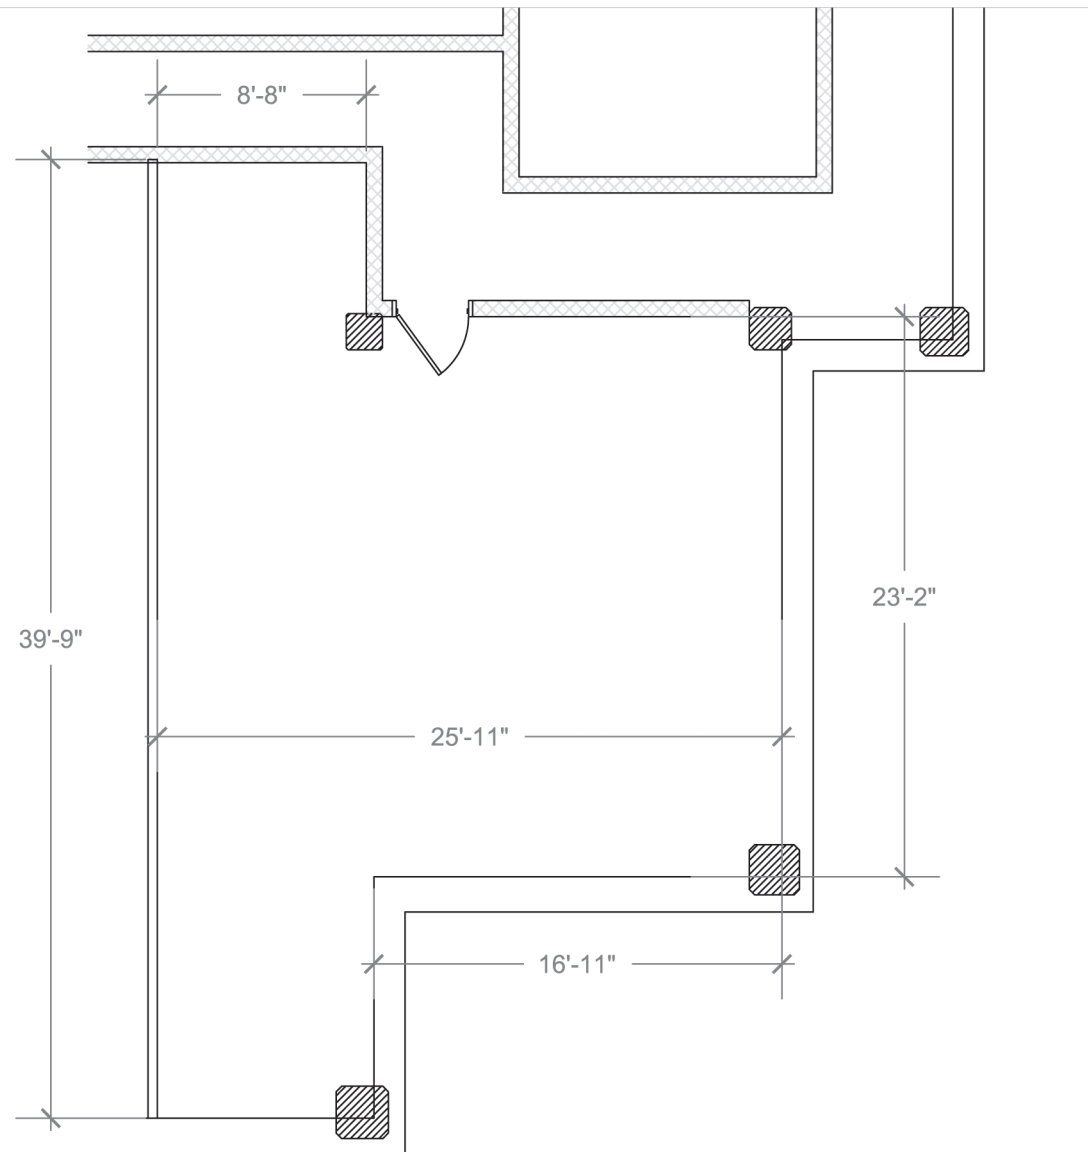

*Plan not to scale - this is not a construction document.*