




Columbia Corporate Park 100 6011 University Blvd., Suite 200 Ellicott City, MD 21043

Office Flex Warehouse Distribution Design-Build Green-Build Retail

Nearly 16 million square feet throughout the Baltimore/Washington area

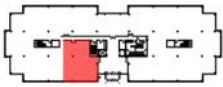

BUILDING KEY PLAN

AVAILABLE - 2,509 SF

2,509 SF - OFFICE

0 SF - WAREHOUSE

2,509 SF - TOTAL

Plan not to scale - this is not a construction document

