



Columbia Corporate Park 100

6011 University Blvd.
Suite 290
Ellicott City, MD 21043

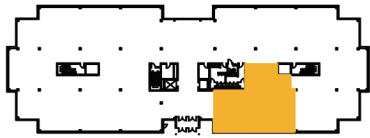

Building Key Plan

Total SF Office
Available
3,197 RSF

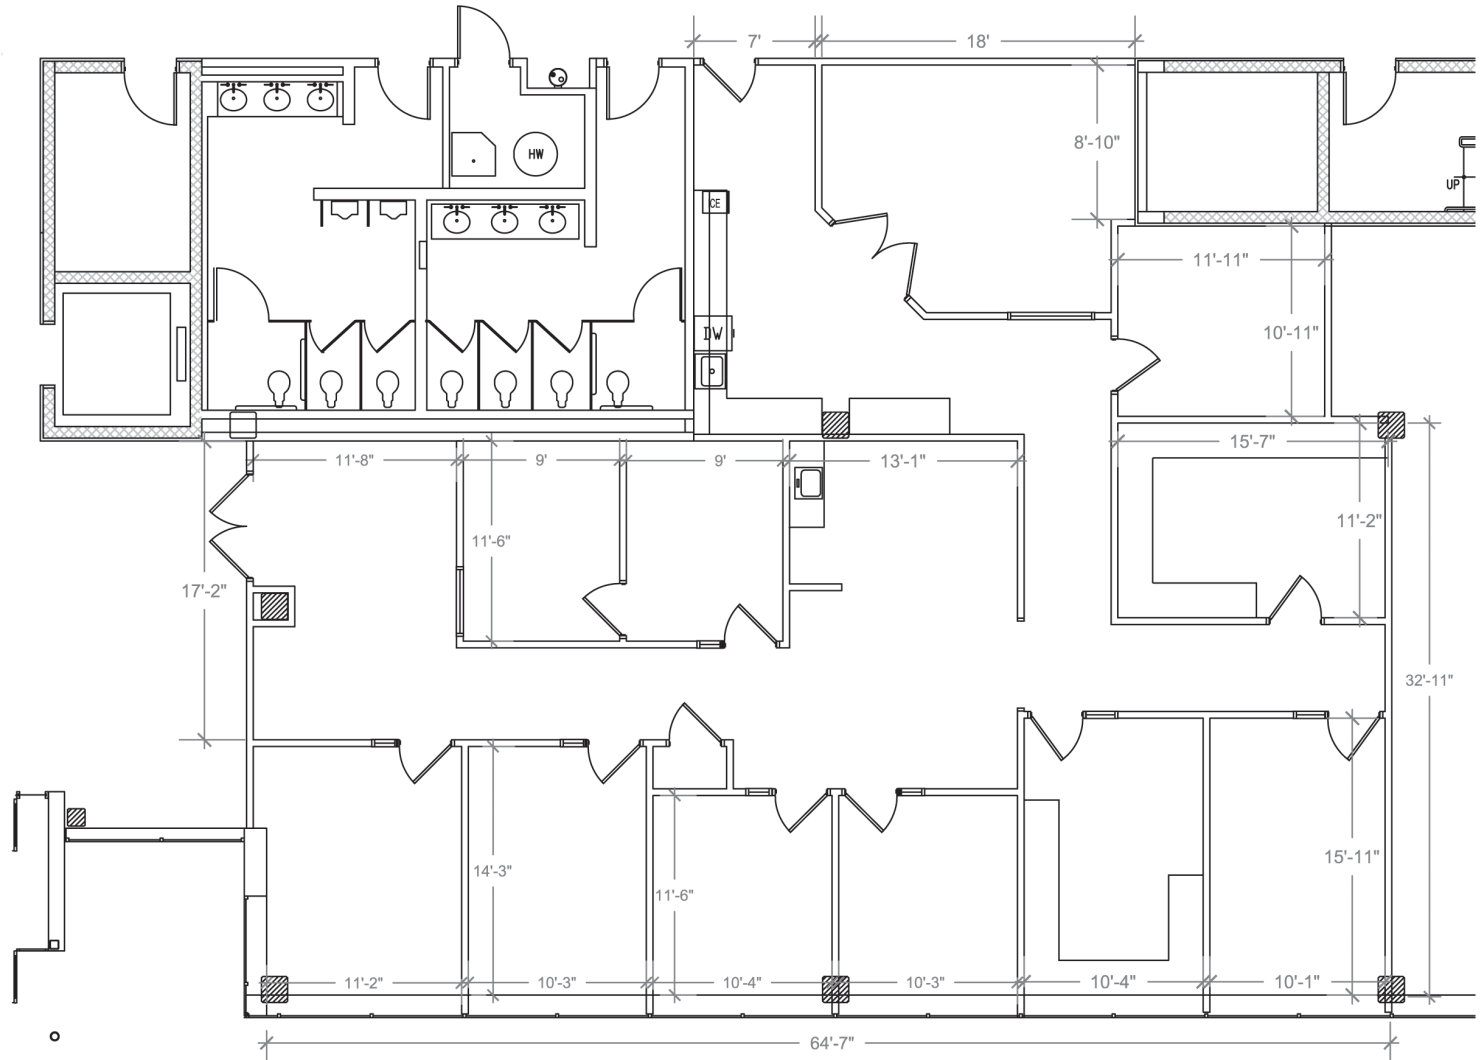

Plan not to scale - this is not a construction document.