


# Columbia Corporate Park 100

6011 University Boulevard  
Suites 430-460  
Ellicott City, MD 21043



Building Key Plan

Total SF Office Available  
10,195 RSF

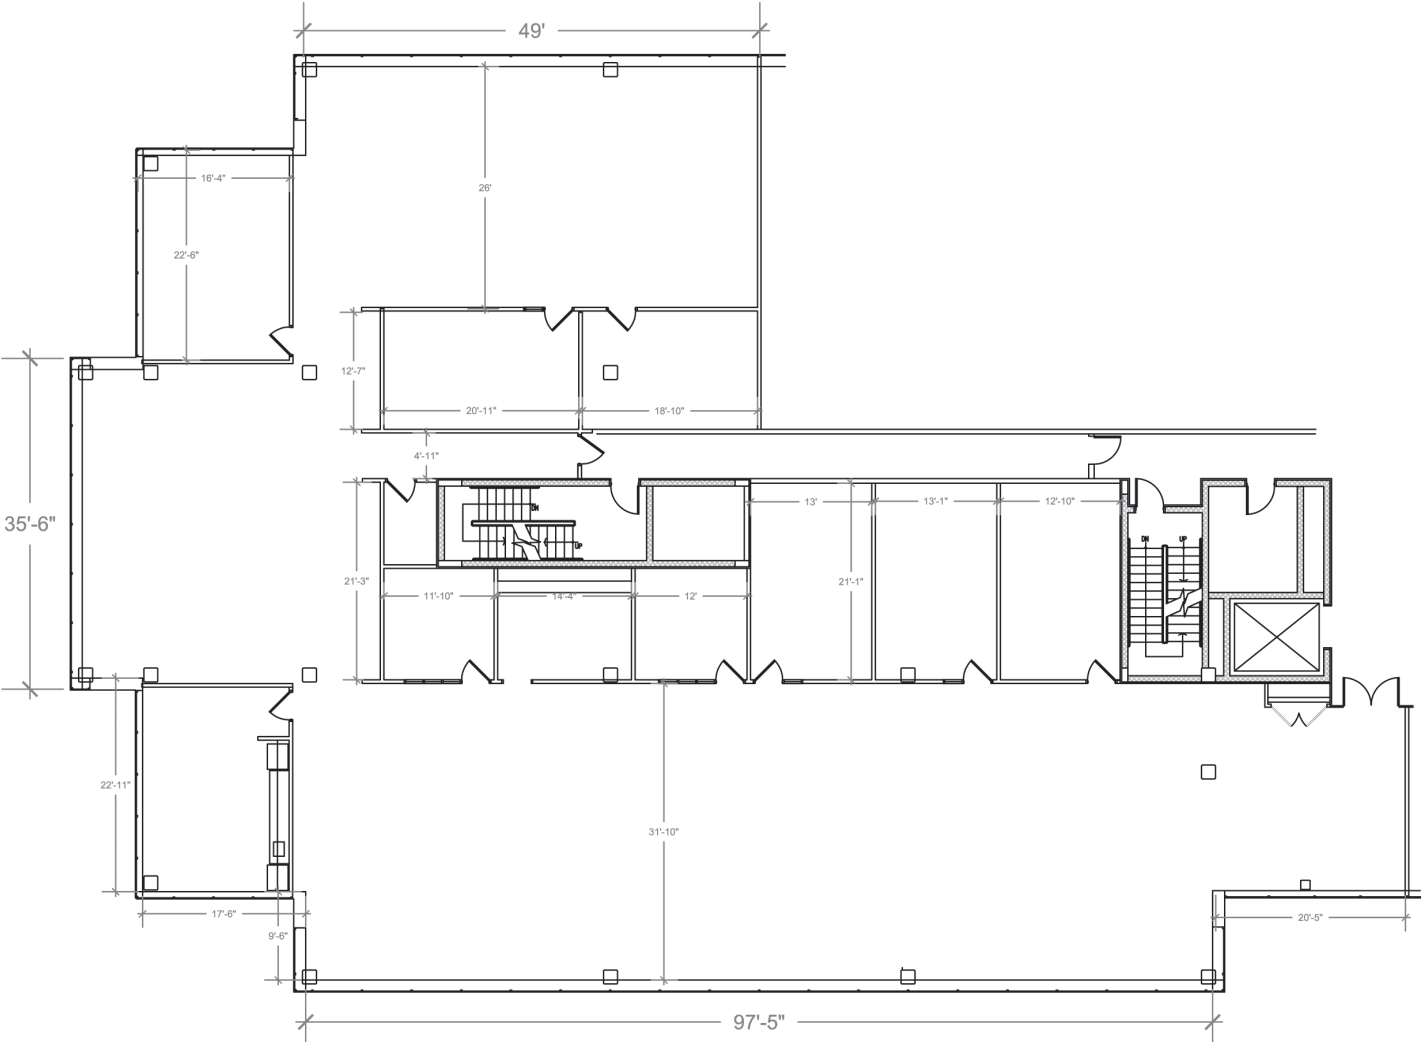

Plan not to scale - this is not a construction document.