


# Columbia Corporate Park

6031 University Boulevard  
Suite 235  
Ellicott City, MD 21043



Building Key Plan

Total SF Office Available  
2,384 RSF

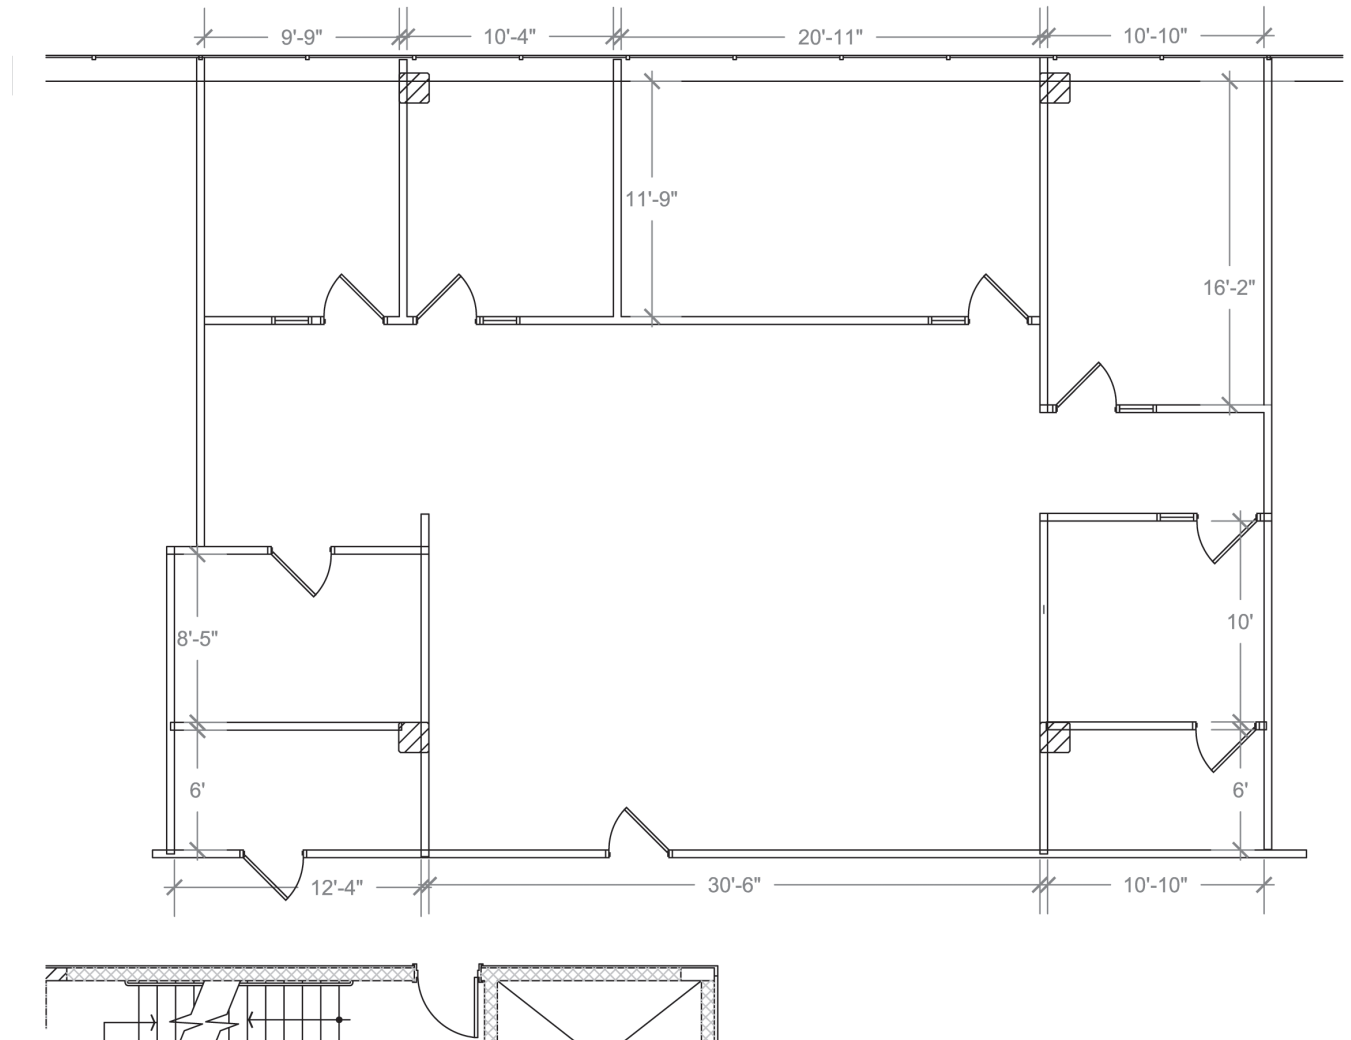

Plan not to scale - this is not a construction document.