


# Columbia Corporate Park

6031 University Boulevard  
Suite 245  
Ellicot City, MD 2103



Building Key Plan

Total SF Office Available  
1,430 RSF

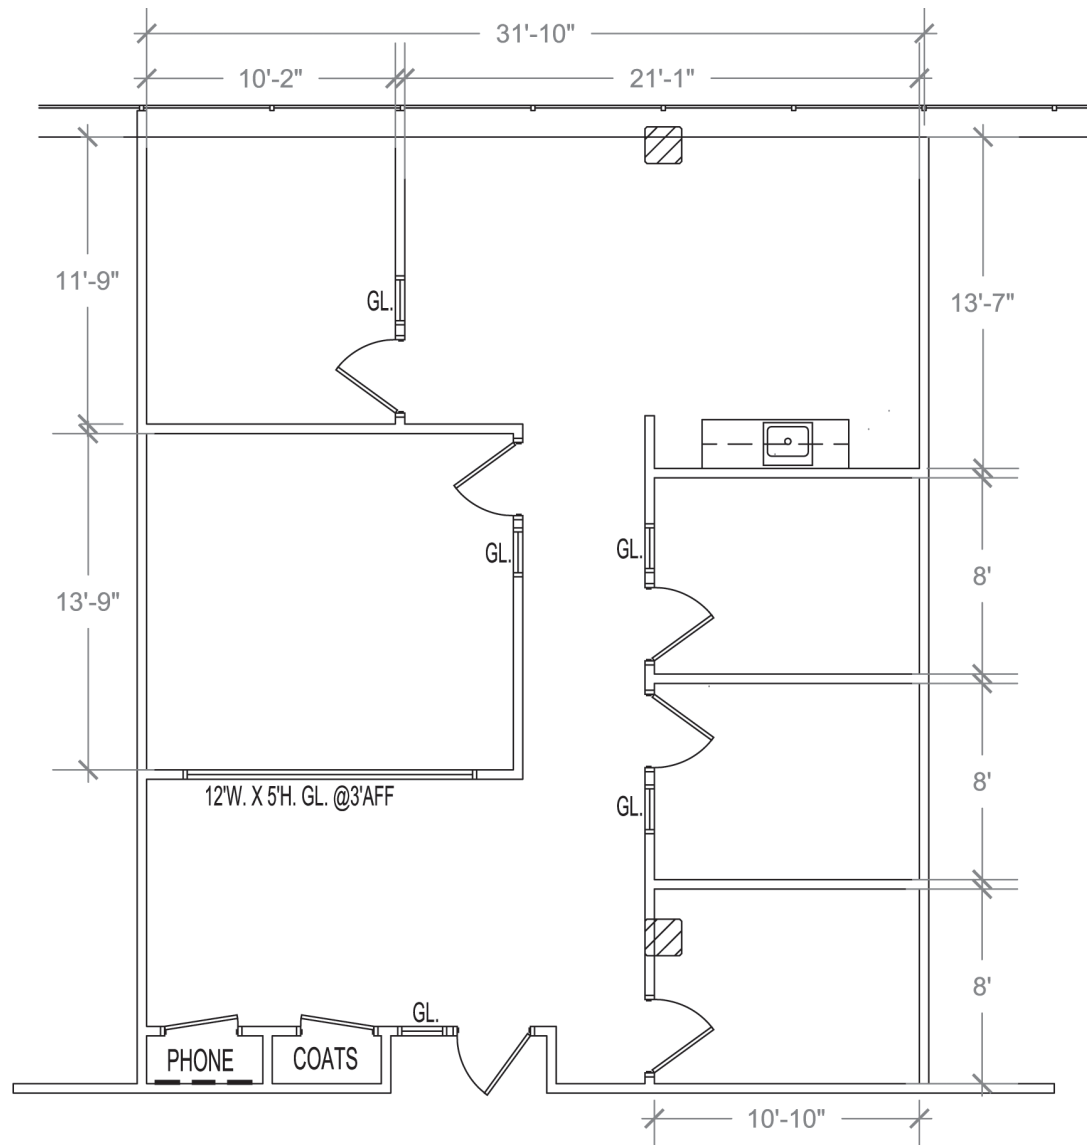

Plan not to scale - this is not a construction document.