


Columbia Corporate Park 100

6031 University Boulevard
Suite 290
Ellicott City, MD 21043

Total SF Office Available
6,601 RSF



Building Key Plan

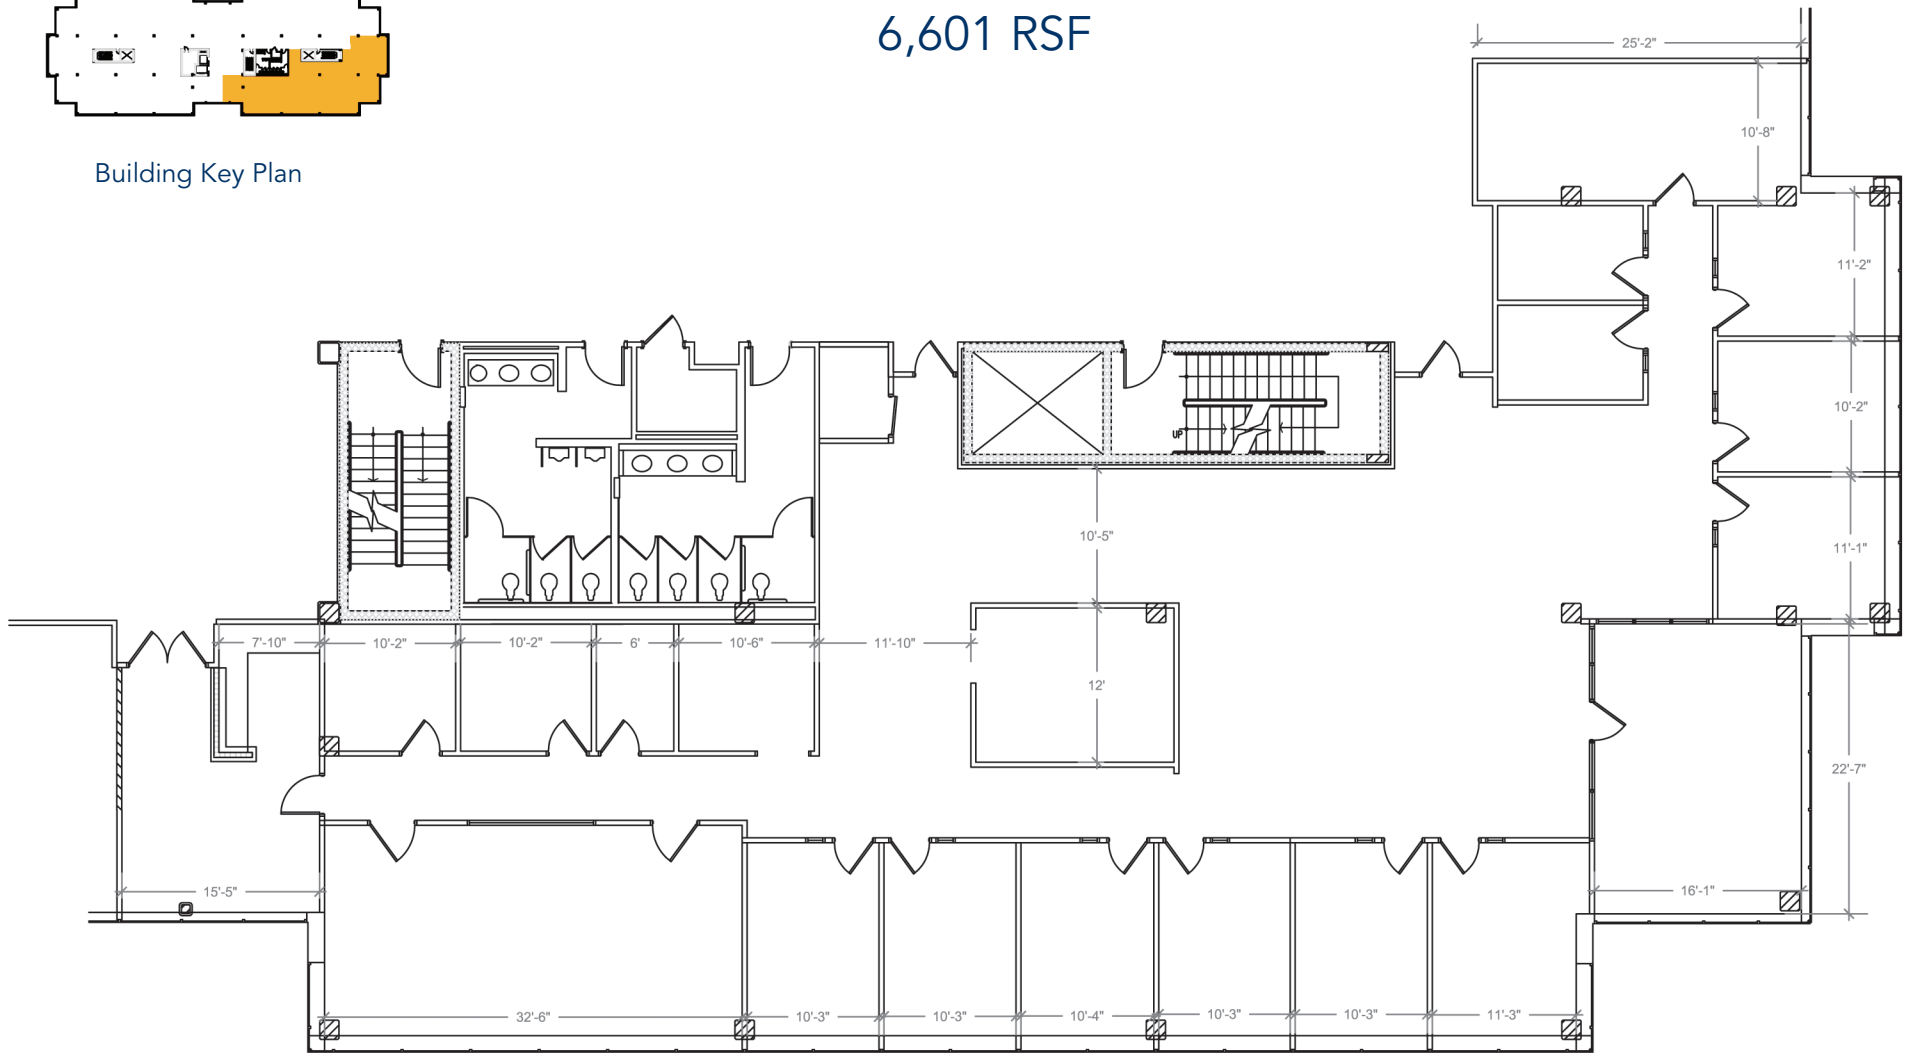

Plan not to scale - this is not a construction document.