



Baltimore Commons

7484 Candlewood Road
Suites F-J
Hanover, MD 21076

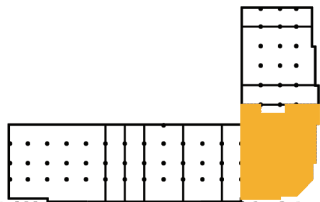

Building Key Plan

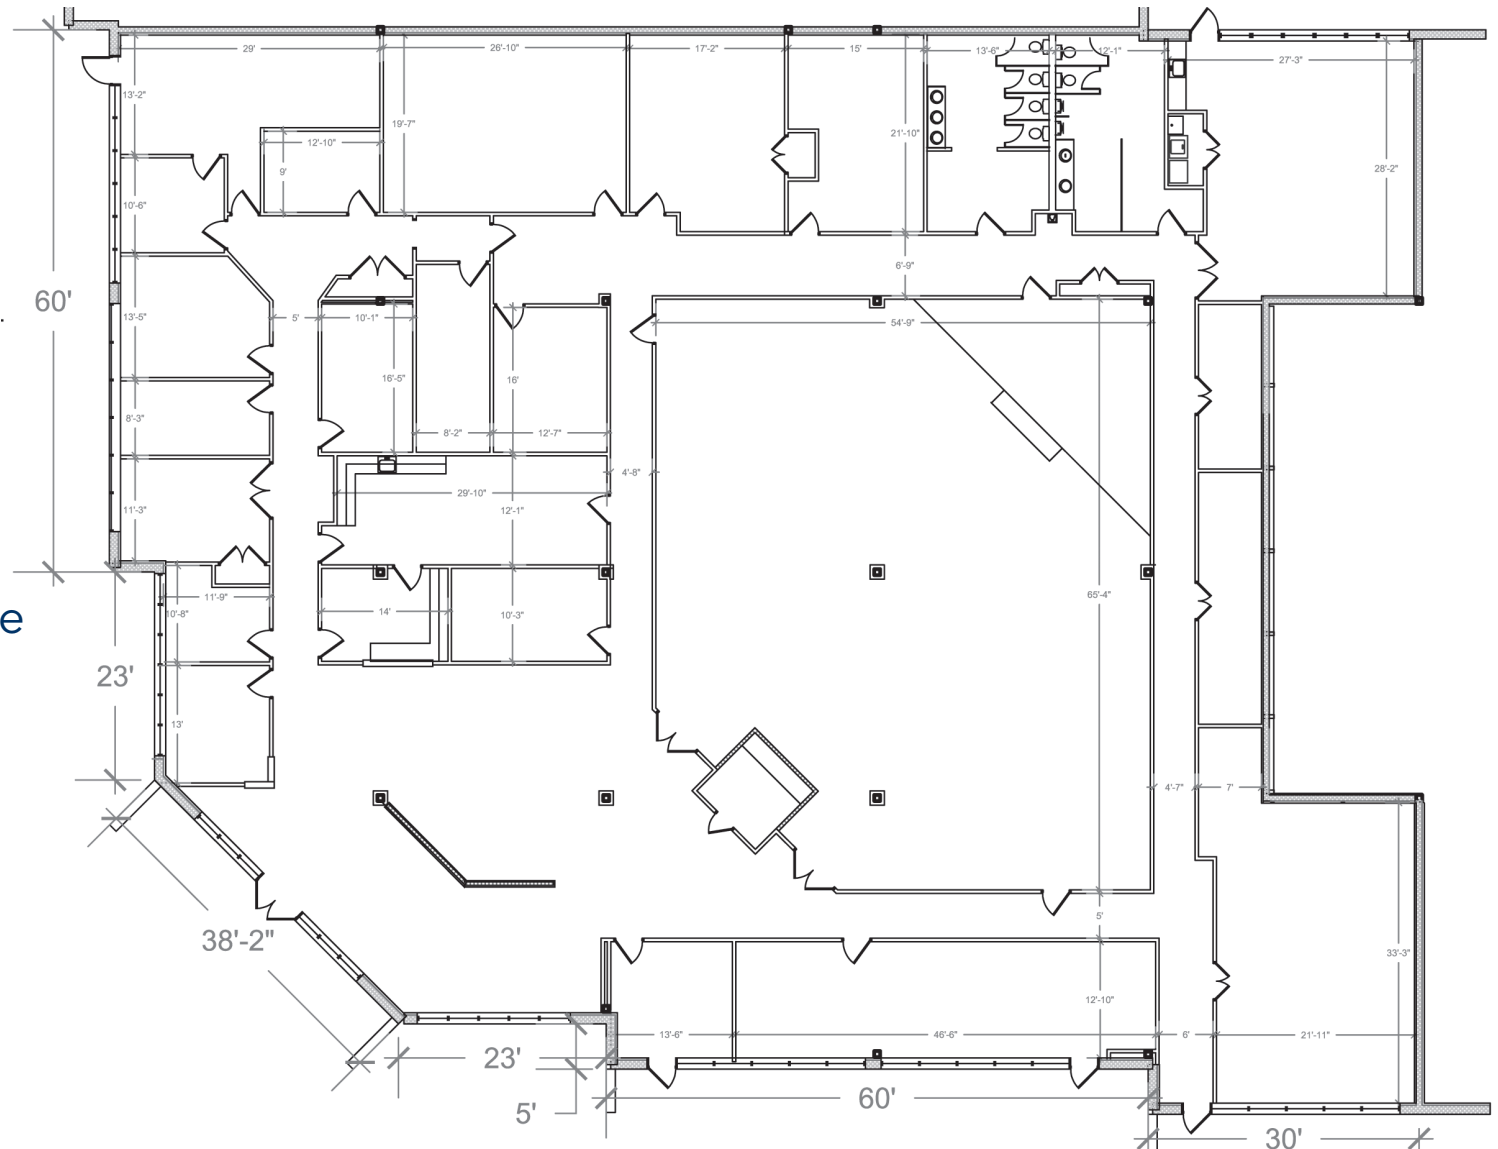

Total SF Office Available
15,004 RSF

Plan not to scale - this is not a construction document.