

4711 Hollins Ferry


4711 Hollins Ferry Road
Suites 115-117
Baltimore, MD 21227



Building Key Plan

Total Warehouse Available

30,149 RSF

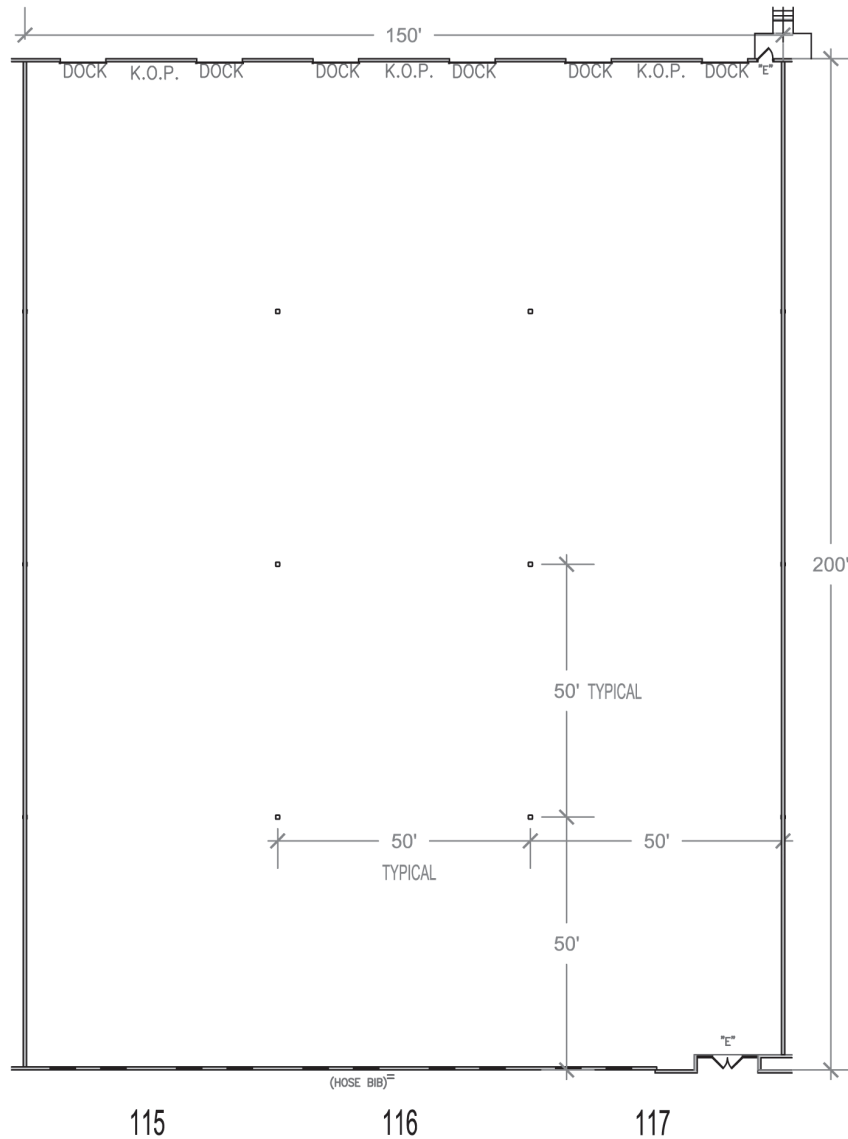

Plan not to scale - this is not a construction document.