



Hammonds North

825 Hammonds Ferry Road
Suite A (Rear)
Linthicum, MD 21090

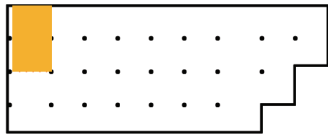

Building Key Plan

Total SF Office Available
2,100 RSF

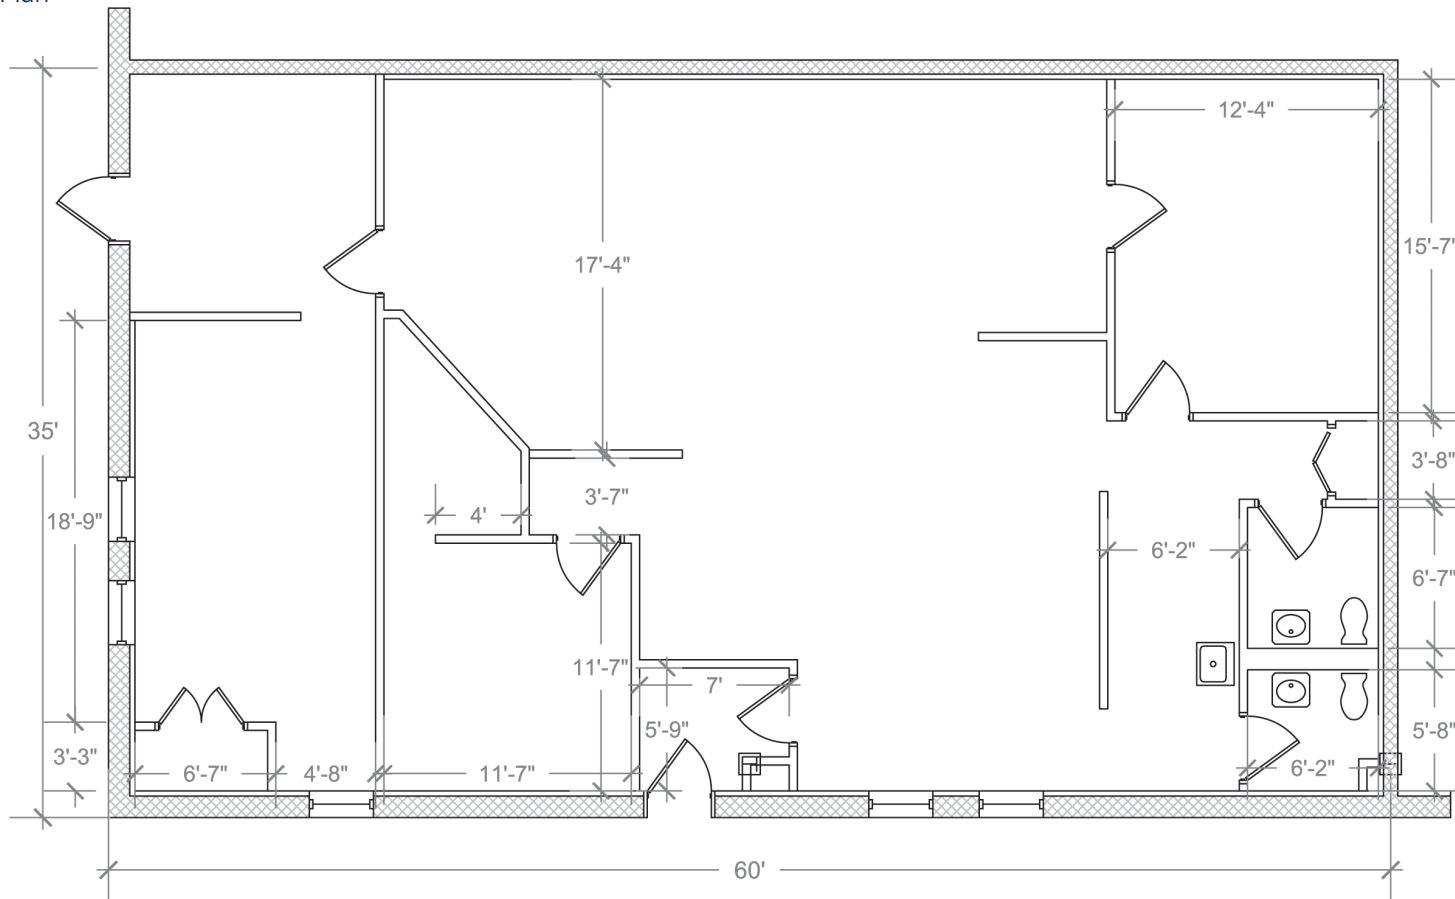

Plan not to scale - this is not a construction document.