


Baltimore Commons


7465 Candlewood Road
Suites A-F
Hanover, MD 21076

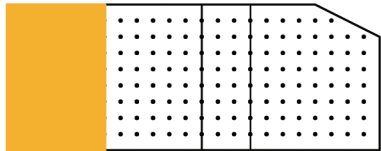

Building Key Plan

Total SF Available
48,600 SF

Office - 2,118 SF
Warehouse - 46,482 SF

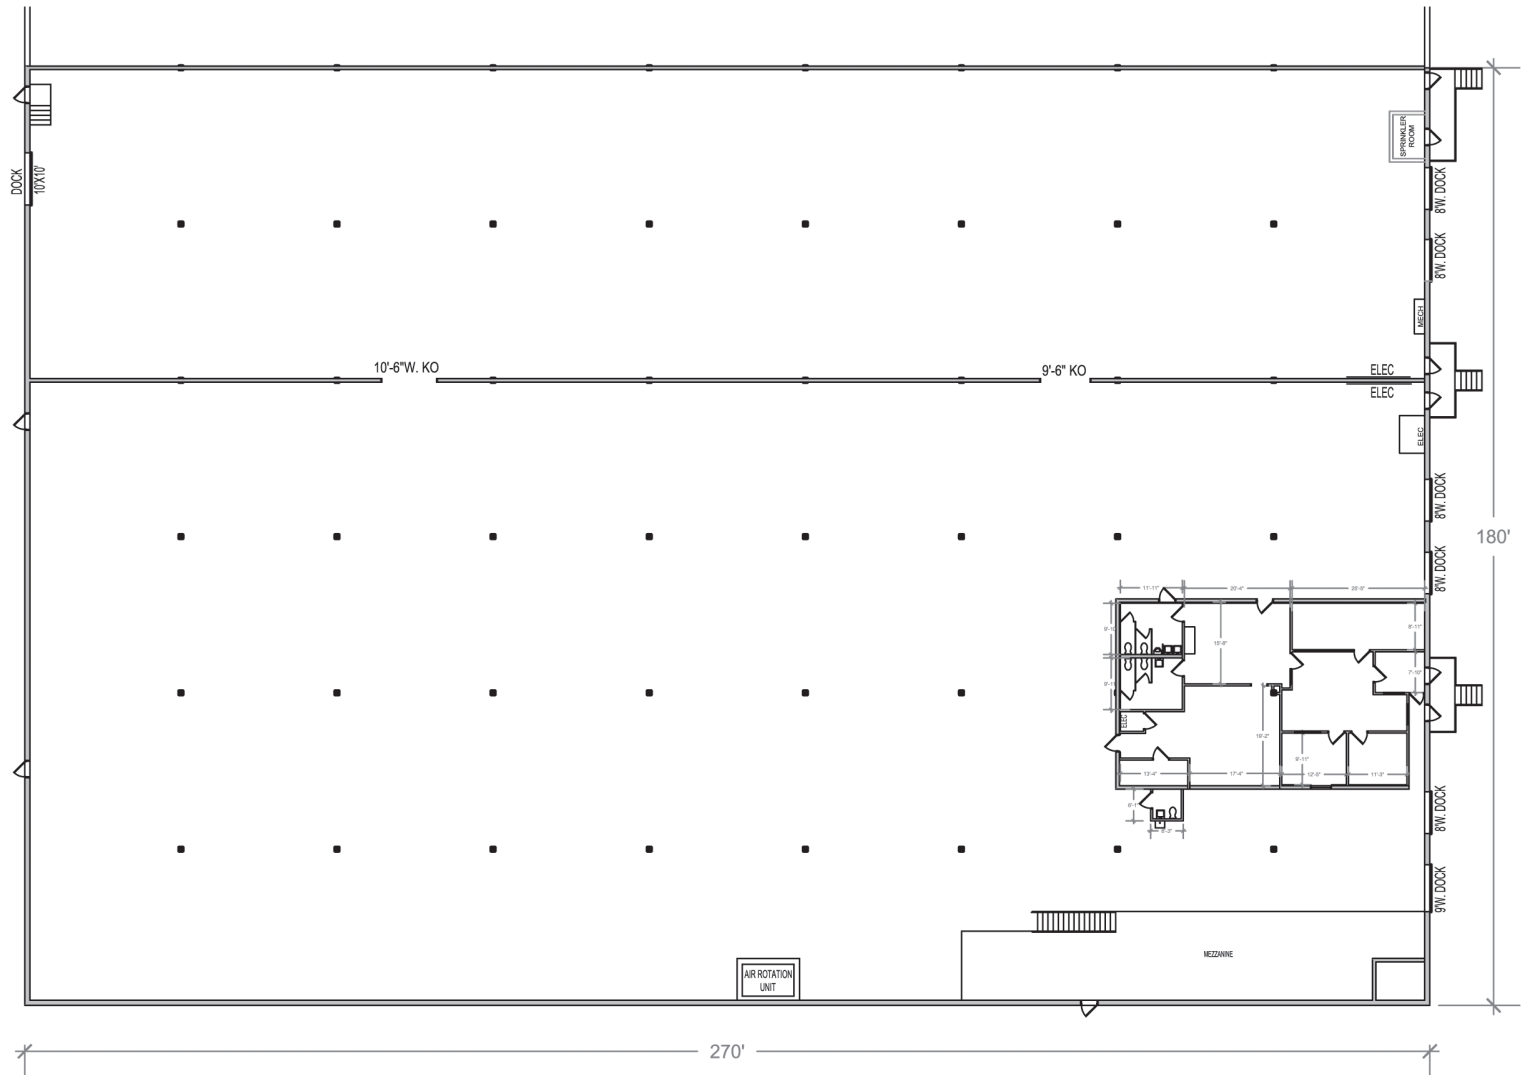

Plan not to scale - this is not a construction document.